

Project Manual

For

Frank Ignatius Grein Softball Field Renovations



For

Northern Kentucky University

Highland Heights, KY 41099

Project # - 080115.036
Project Record Drawings
April 2021

By



Sportworks Field Design
A Division of Kleingers
6219 Centre Park Drive
West Chester, OH 45069
513-779-7851

NORTHERN KENTUCKY UNIVERSITY CAMPBELL COUNTY SOFTBALL FIELD RENOVATIONS LOUIE B NUNN DR. HIGHLAND HEIGHTS, KENTUCKY 41099



SITE DATA:

OWNER:
NORTHERN KENTUCKY UNIVERSITY
LOUIE B NUNN DR,
HIGHLAND HEIGHTS, KY 41099
CONTACT: MARY PAULA SCHUH
(859)-572-5120

SITE ENGINEER:
SPORTWORKS FIELD DESIGN
6219 CENTRE PARK DRIVE
WEST CHESTER, OH 45069
CONTACT: BRAD D'AGNILLO
513-779-7851

TOPOGRAPHIC:
PER SURVEY BY THE KLEINGERS GROUP
DATED SEPTEMBER 2019 COMPILED
WITH RECORD DRAWINGS DATED
01/28/2020

SHEET INDEX	
PAGE	TITLE
C000	TITLE SHEET
C100	GENERAL NOTES & DETAILS
C110	SURVEY BASEMAP
C111	SUPPLEMENTARY SURVEY BASEMAP
C120	DEMOLITION PLAN
C130	LOCATION PLAN
C140	UTILITY PLAN
C141	STORM PROFILES
C142	IRRIGATION PLAN
C150	GRADING PLAN
C160	EROSION CONTROL NOTES
C161	EROSION CONTROL NOTES & DETAILS
S100	STRUCTURAL DETAILS

VICINITY MAP:



**NORTHERN KENTUCKY UNIVERSITY
FRANK IGNATIUS GREIN SOFTBALL
FIELD RENOVATIONS**

SEAL:

NO.	DATE	DESCRIPTION
1	04/30/2021	FOR BID

**NKU SOFTBALL
FIELD
RENOVATIONS**
CITY OF HIGHLAND HEIGHTS
CAMPBELL COUNTY
COMMONWEALTH OF KENTUCKY

PROJECT NO: 080115.036

DATE: APRIL 2021

SCALE:

SHEET NAME:

TITLE SHEET

SHEET NO.

C000



Know what's below.
Call before you dig.

GENERAL NOTES




- CONTRACTOR SHALL OBTAIN ALL NECESSARY PERMITS FOR CONSTRUCTION ACTIVITIES IN ACCORDANCE WITH LOCAL, STATE, & FEDERAL REGULATIONS.
- THE CONTRACTOR IS TO PERFORM ALL INSPECTIONS AS REQUIRED BY THE KENTUCKY EPA FOR THE NATIONAL POLLUTANT DISCHARGE ELIMINATION SYSTEM (NPDES) PERMIT AND FURNISH OWNERS REPRESENTATIVE WITH WRITTEN REPORTS. OWNER WILL OBTAIN PERMITS.
- ITEM NUMBERS REFER TO THE KENTUCKY TRANSPORTATION CABINET CONSTRUCTION AND MATERIAL SPECIFICATIONS, AND ALL CONSTRUCTION WORK SHALL BE DONE ACCORDING TO SAID SPECIFICATIONS AND IN ACCORDANCE WITH APPLICABLE STANDARDS OF THE CITY OF HIGHLAND HEIGHTS AND CAMPBELL COUNTY. WHEN IN CONFLICT, THE KYTC REQUIREMENTS SHALL PREVAIL.
- PROTECTION OF EXISTING TREES AND VEGETATION: PROTECT EXISTING TREES AND OTHER VEGETATION AGAINST UNNECESSARY CUTTING, BREAKING OR SKINNING OF ROOTS, SKINNING OR BRUISING OF BARK, SMOTHERING OF TREES BY STOCKPILING CONSTRUCTION MATERIALS OR EXCAVATED MATERIALS WITHIN DRIP LINE, EXCESS FOOT OR VEHICULAR TRAFFIC, OR PARKING OF VEHICLES WITHIN DRIP LINE. PROVIDE TEMPORARY GUARDS TO PROTECT TREES AND VEGETATION TO BE LEFT STANDING.
- ALL ELEVATIONS SHOWN ARE FINISHED GRADE ELEVATIONS, UNLESS OTHERWISE NOTED.
- SUBGRADE EXCAVATION AND CONSTRUCTION TO BE PER GEOTECHNICAL ENGINEER'S RECOMMENDATIONS. SUBGRADE PREPARATION SHALL BEGIN BY CLEARING & STRIPPING UNSUITABLE MATERIAL FROM SITE. THEN PLACE & COMPACT BACKFILL MATERIAL AT GEOTECHNICAL ENGINEER'S RECOMMENDATIONS. ALL BACKFILL MATERIAL MUST BE ACCEPTABLE TO THE GEOTECHNICAL ENGINEER.
- COMPACTED FILLS ARE TO BE MADE TO A MINIMUM OF THREE FEET ABOVE THE CROWN OF ANY PROPOSED SEWER PRIOR TO CUTTING OF TRENCHES FOR PLACEMENT OF SAID SEWERS. ALL FILLS SHALL BE CONTROLLED, COMPACTED, AND INSPECTED BY AN APPROVED TESTING LABORATORY OR AN INSPECTOR FROM THE APPROPRIATE GOVERNMENTAL AGENCY.
- ADJUST ALL EXISTING CASTINGS AND CLEANOUTS WITHIN PROJECT AREA TO GRADE AS REQUIRED.
- CONTRACTOR SHALL IMPLEMENT ALL SOIL AND EROSION CONTROL, PRACTICES REQUIRED BY CAMPBELL COUNTY AND SD1.
- ALL GROUND SURFACE AREAS THAT HAVE BEEN EXPOSED OR LEFT BARE AS A RESULT OF CONSTRUCTION SHALL BE SEEDED AS SOON AS PRACTICAL IN ACCORDANCE WITH SPECIFICATIONS.
- ALL PROPOSED STORM SEWERS, SURFACE OR OTHER DRAINAGE FACILITIES ARE PRIVATE AND MAINTAINED BY THE OWNER.
- THE CONTRACTOR IS TO CONSTRUCT CURBS, CATCH BASINS, DOWNSPOUTS, PIPING AND CONNECTION ETC. AS REQUIRED TO CONVEY THE PAVED SURFACE DRAINAGE TO THE EXISTING DRAINAGE SYSTEM.
- THE CONTRACTOR IS RESPONSIBLE FOR BALANCING THE SITE EARTHWORK BY IMPORTING OR EXPORTING AS NECESSARY TO ACHIEVE DESIGN GRADES AND SPECIFICATIONS.
- ANY FIELD TILE CUT MUST BE TIED INTO THE STORM DRAINAGE SYSTEM.
- THE CONTRACTOR SHALL VERIFY LOCATION AND ELEVATION OF ALL EXISTING UTILITIES PRIOR TO THE BEGINNING OF CONSTRUCTION OR EARTH MOVING OPERATIONS.
- ALL DIMENSIONS ARE TO THE OUTSIDE FACE OF BUILDING, EDGE OF PAVEMENT AND/OR FACE OF CURB, UNLESS OTHERWISE NOTED.
- ALL TEMPORARY EROSION AND SEDIMENT CONTROL MEASURES WILL BE DISPOSED OF AFTER FINAL SITE STABILIZATION IS ACHIEVED OR AFTER THE TEMPORARY MEASURES ARE NO LONGER NEEDED. TRAPPED SEDIMENT AND OTHER DISTURBED SOIL AREAS RESULTING FROM THE DISPOSITION OF TEMPORARY MEASURES WILL BE PERMANENTLY REMOVED OR STABILIZED TO PREVENT EROSION AND SEDIMENTATION.
- ALL TEMPORARY AND PERMANENT EROSION AND SEDIMENT CONTROL MEASURES WILL BE MAINTAINED AND REPAIRED AS NEEDED TO ASSURE CONTINUED PERFORMANCE OF THEIR INTENDED FUNCTION.
- DANDY BAGS TO BE USED AT ALL STORM INLETS FOR EROSION CONTROL.
- SANITATION DISTRICT NO. 1 IS TO BE CONTACTED 72 HOURS PRIOR TO ANY CONSTRUCTION ACTIVITY AT (859) 578-8892.

UTILITY NOTES


- ALL CLEAR WATER CONNECTIONS TO THE SANITARY SEWER SYSTEM ARE PROHIBITED.
- ALL STORM STRUCTURES ARE KYTC TYPES UNLESS OTHERWISE INDICATED.
- STORM SEWER PIPE LABELED "STM" SHALL BE ONE OF THE FOLLOWING: PVC SDR-35, OR HIGH DENSITY POLYETHYLENE. STORM SEWER PIPE LABELED "RCP" SHALL BE REINFORCED CONCRETE PIPE. ALL STORM PIPE USED MUST HAVE A MANUFACTURER SPECIFIED FRICTION FACTOR OF 0.013 (H=0.013) OR LESS.
- STEPS SHALL BE PROVIDED IN ALL CATCH BASINS AND MANHOLES OVER 4' DEEP.
- CONTRACTOR SHALL SECURE ALL PERMITS AND FURNISH ALL DRAWINGS REQUIRED FOR UTILITY TAPS PRIOR TO STARTING CONSTRUCTION.
- PROVIDE MANUFACTURERS RECOMMENDED COVER OVER TOP OF STORM PIPE DURING CONSTRUCTION, UNTIL PAVING OPERATIONS BEGIN.
- SITE UTILITY CONTRACTOR SHALL BE RESPONSIBLE FOR PROVIDING REQUIRED VERTICAL SEPARATION BETWEEN UTILITIES BY VARYING DEPTH OF UNDERGROUND ELECTRIC, TELEPHONE, WATER AND GAS.
- A MINIMUM OF 1.5' OF VERTICAL CLEARANCE SHALL BE MAINTAINED BETWEEN UTILITIES AT ALL TIMES.
- FORTY-EIGHT HOURS BEFORE DIGGING IS TO COMMENCE, THE CONTRACTOR SHALL NOTIFY THE KENTUCKY UNDERGROUND PROTECTION SERVICE, AND ALL OTHER AGENCIES WHICH MAY HAVE UNDERGROUND UTILITIES INVOLVING THIS PROJECT AND ARE NON-MEMBERS OF THE KENTUCKY UNDERGROUND PROTECTION SERVICE.
- EXISTING UNDERGROUND UTILITIES AND SERVICES ARE SHOWN IN THEIR APPROXIMATE LOCATIONS ACCORDING TO THE BEST INFORMATION AVAILABLE. THE LOCATIONS SHOWN ARE INTENDED ONLY AS A GUIDE AND CANNOT BE GUARANTEED ACCURATE. THE CONTRACTOR SHALL BE RESPONSIBLE FOR:
 - CONTACTING THE INDIVIDUAL UTILITY OWNERS TEN DAYS PRIOR TO CONSTRUCTION AND ADVISING THEM OF THE WORK TO TAKE PLACE.
 - SOLICITING THEIR AID IN LOCATING AND PROTECTING ANY UTILITY WHICH MAY INTERFERE WITH CONSTRUCTION.
 - EXCAVATING AND VERIFYING THE HORIZONTAL AND VERTICAL LOCATION OF EACH UTILITY.
 - ALL DAMAGE TO ANY EXISTING UTILITY.

GRADING & EROSION CONTROL NOTES


- THE NPDES PERMIT REQUIRES THAT ALL AREAS WHICH ARE AT OR NEAR FINAL GRADE, OR WHICH REMAIN DORMANT FOR MORE THAN 21 DAYS OR LONGER BE STABILIZED WITHIN 7 DAYS OF LAST ACTIVITY. VELOCITY DISSIPATION DEVICES SHOULD BE PLACED AT THE OUTFALL OF ALL DETENTION OR RETENTION STRUCTURES AND ALONG THE LENGTH OF ANY OUTFALL CHANNEL AS NECESSARY TO PROVIDE A NON-EROSIVE FLOW VELOCITY FROM THE STRUCTURE TO THE WATER COURSE.
- THE NPDES PERMIT REQUIRES THAT SEDIMENT AND EROSION CONTROLS BE INSPECTED ONCE EVERY 7 DAYS AND WITHIN 24 HOURS OF 0.5" OR GREATER RAINFALL. A WRITTEN LOG SHOULD INDICATE THE DATE OF INSPECTION NAME OF INSPECTOR, WEATHER CONDITIONS, OBSERVATIONS, ACTIONS TAKEN TO CORRECT ANY PROBLEMS AND THE DATE ACTION WAS TAKEN.
- SOLID, SANITARY AND TOXIC WASTE MUST BE DISPOSED OF IN A PROPER MANNER IN ACCORDANCE WITH STATE, LOCAL AND FEDERAL REGULATIONS.
- TEMPORARY SEEDING TYPES:
 - TALL FESCUE—SEED AT A RATE OF 50 LBS./ACRE (1 LB./100 SQ. FT.) AND MULCH WITH STRAW AT A RATE OF 2 TONS PER ACRE (80 LBS./1000 SQ. FT.). ESTABLISH BETWEEN MARCH 15 AND SEPTEMBER 30. COVER THE SEED 1/4-1/2 INCH BY RAKE OR SIMILAR TOOL. THIS IS THE MOST WIDELY USED AND BEST ADAPTED GRASS FOR STREAMBANK SEEDINGS. IT HAS GOOD TOLERANCE TO WET SOILS AND FLOODING. IT IS ALSO WELL ADAPTED TO WELL DRAINED SOILS.
 - REED CANARYGRASS (PHALARIS ARUNDINACEAE) PLUS TALL FESCUE—SEED THE REED CANARYGRASS AT A RATE OF 15 LBS./ACRE (1 LB./100 SQ. FT.) PLUS 10 LBS./ACRE (1/2 LB./100 SQ. FT.) OF TALL FESCUE. MULCH WITH STRAW AT A RATE OF 2 TONS/ACRE (80 LBS./1000 SQ. FT.). THIS MIXTURE SHOULD ONLY BE SEEDED FROM MARCH 1 TO MAY 15, OR AUGUST 1 TO SEPTEMBER 30. COVER THE SEED 1/4-1/2 INCH BY RAKE OR SIMILAR TOOL. THIS MIXTURE IS ADAPTABLE TO SOILS THAT ARE VERY WET AS WELL AS WELL DRAINED SOIL CONDITIONS. REED CANARYGRASS CAN WITHSTAND EXTENDED PERIODS OF FLOODING. IT IS EXCELLENT FOR EROSION CONTROL. REED CANARYGRASS CAN ALSO BE ESTABLISHED BY SOO STRIPS, USING RHIZOMES, OR FRESHLY CUT CULMS. THE LOCAL CONSERVATION SERVICE OFFICE CAN PROVIDE THE SPECIFIC DETAILS REQUIRED TO USE ONE OF THE ALTERNATIVE ESTABLISHMENT METHODS.

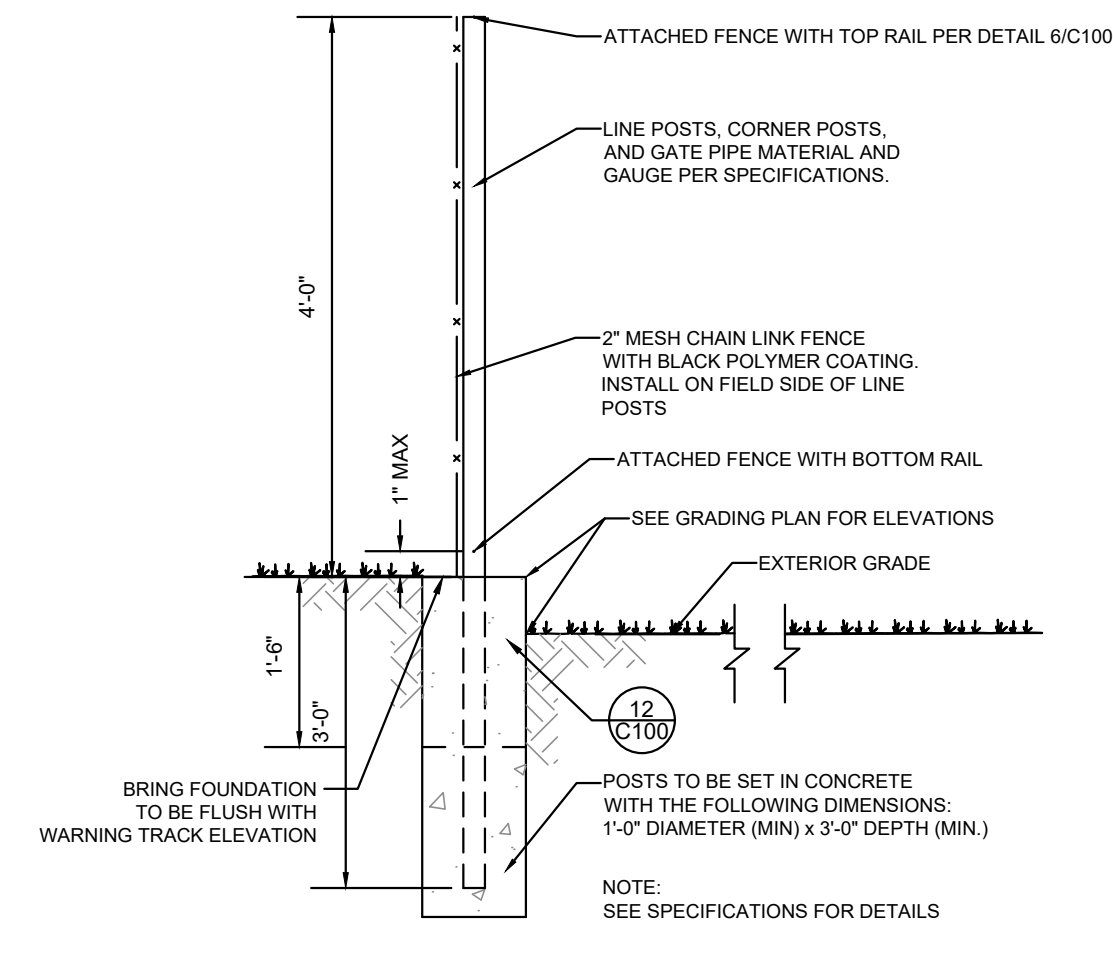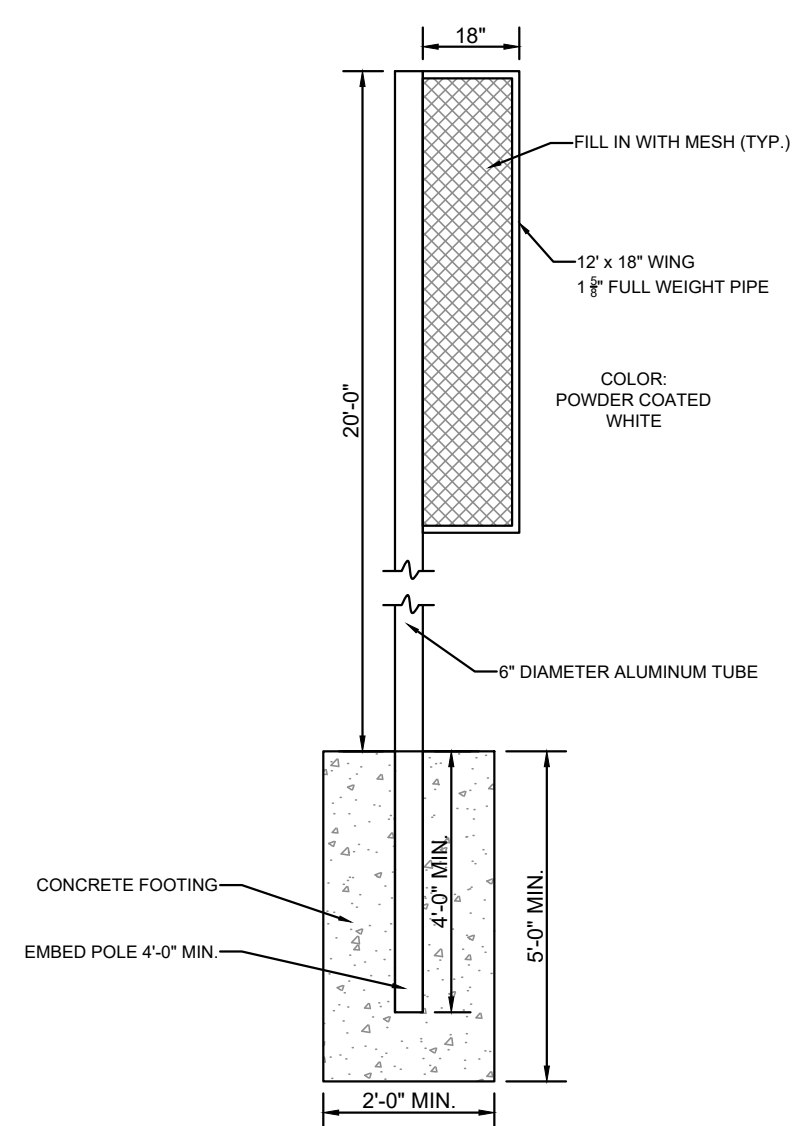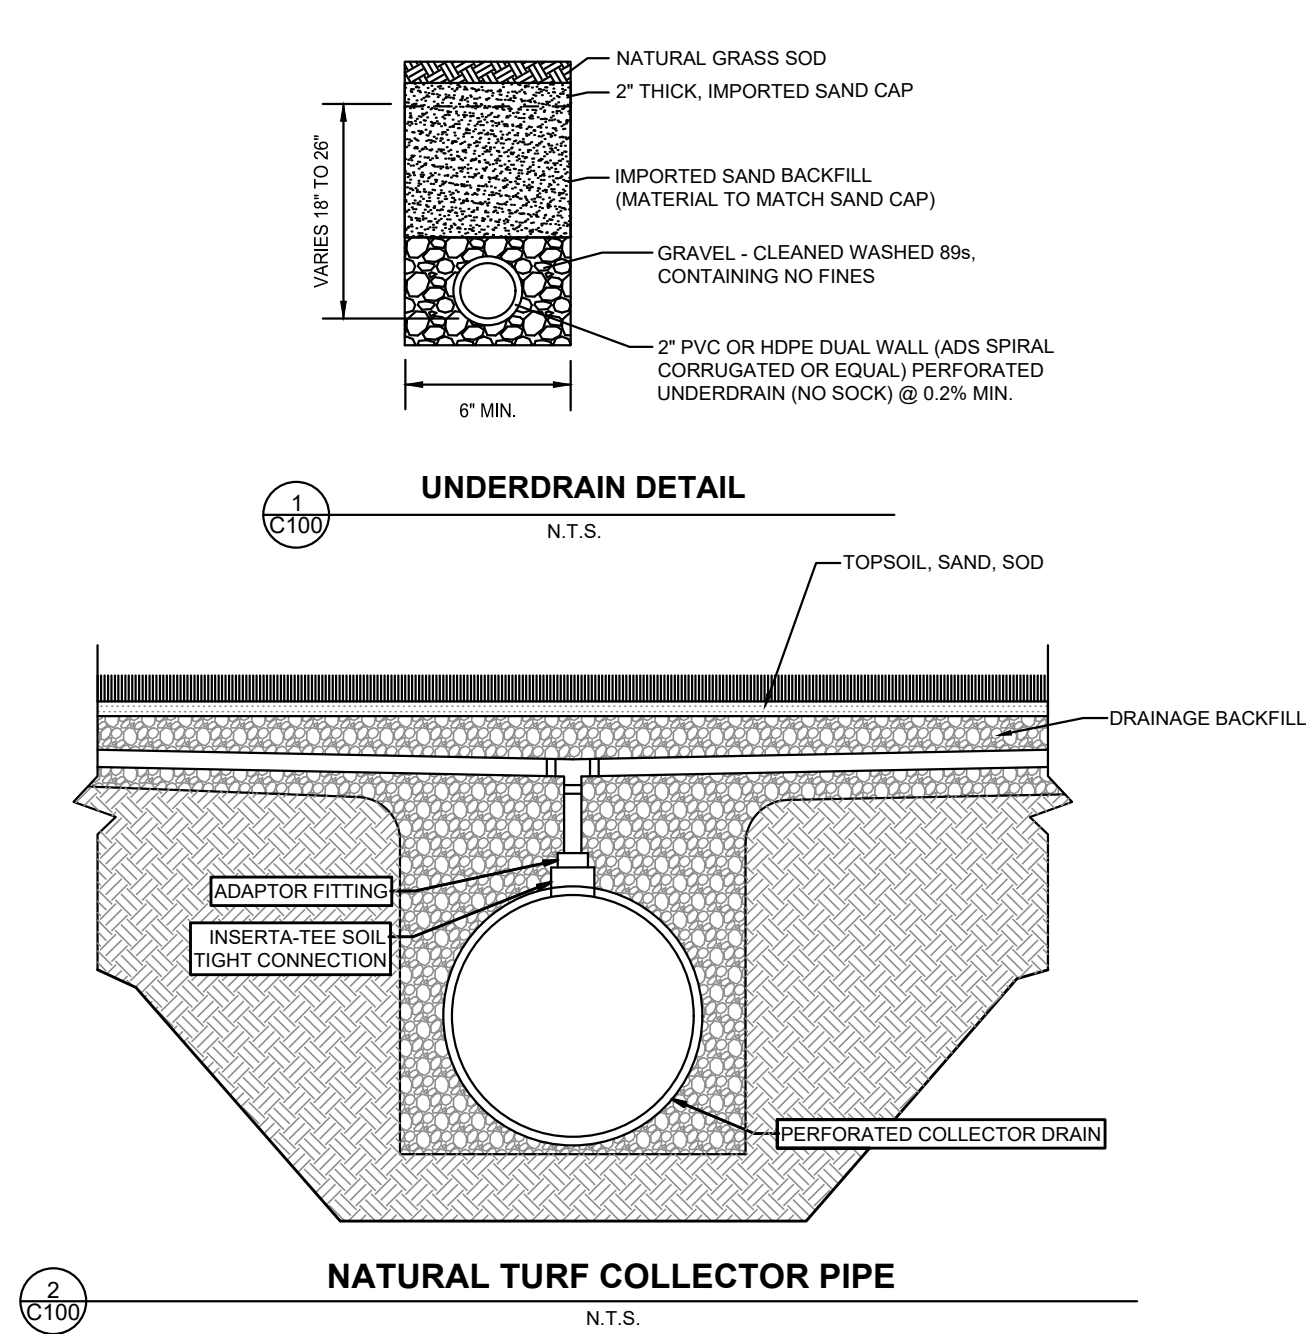


9 C100 4' VINYL COATED CHAIN LINK FENCE N.T.S.

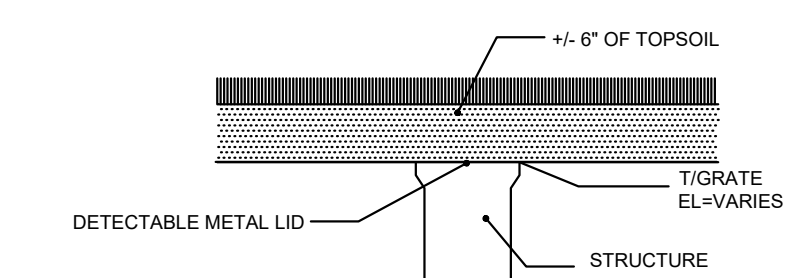


10 C100 MANHOLE SETTING WITHIN FIELD LIMITS N.T.S.

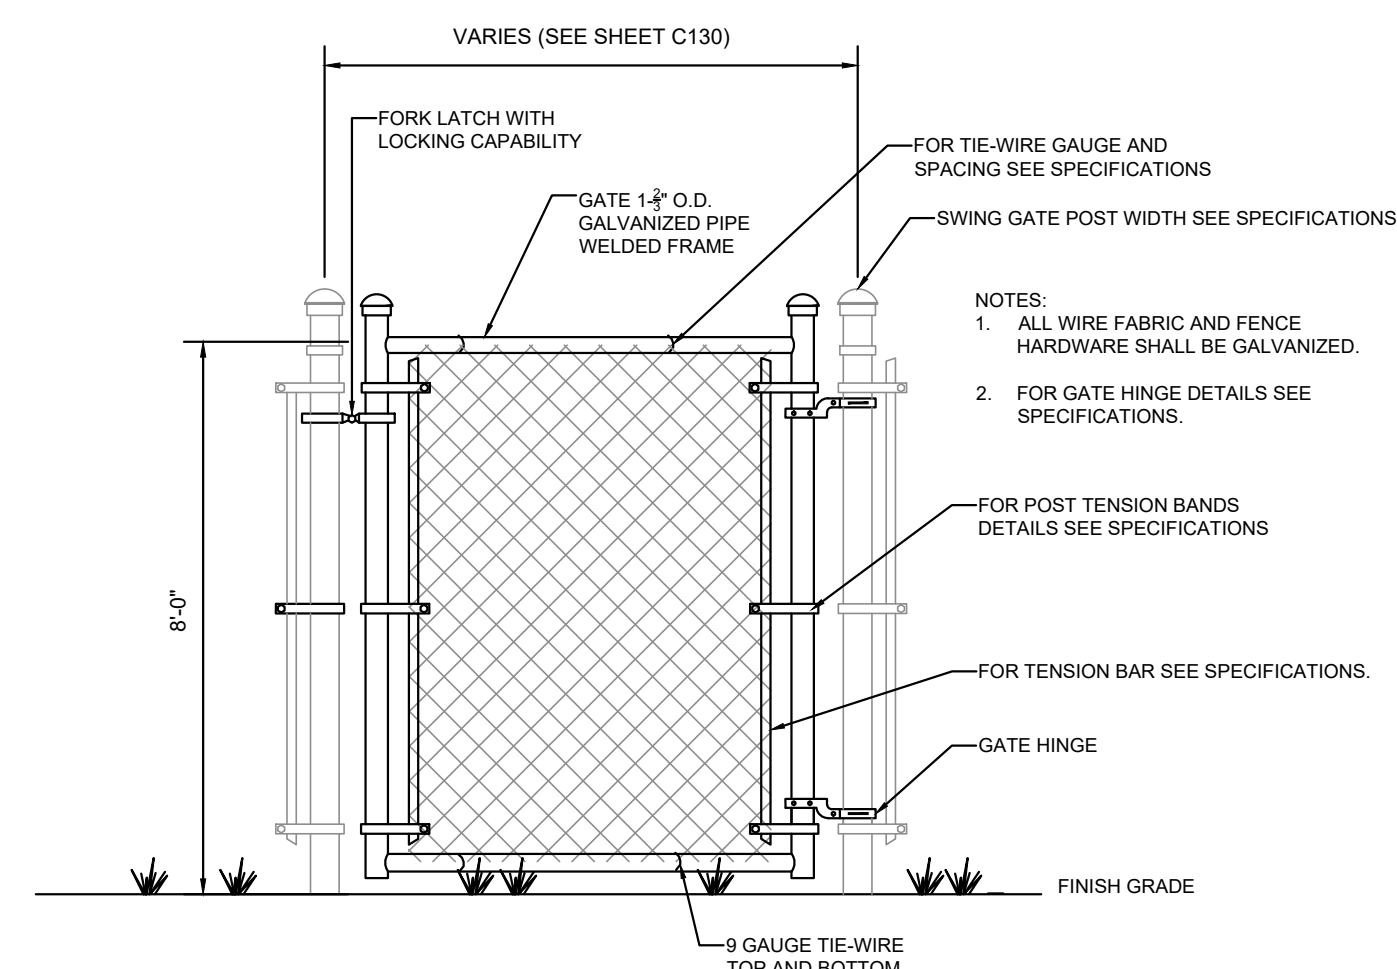


3 C100 8' VINYL COATED CHAIN LINK FENCE GATE DETAIL N.T.S.

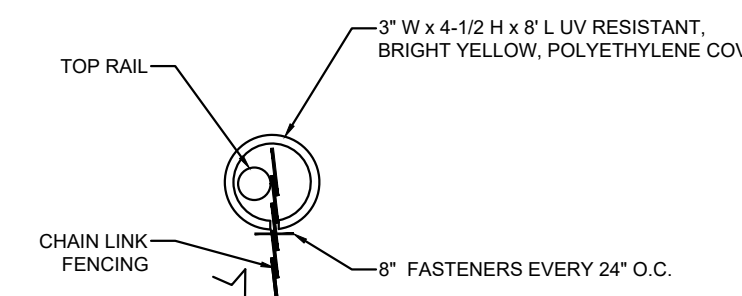


6 C100 TOP RAIL COVER N.T.S.

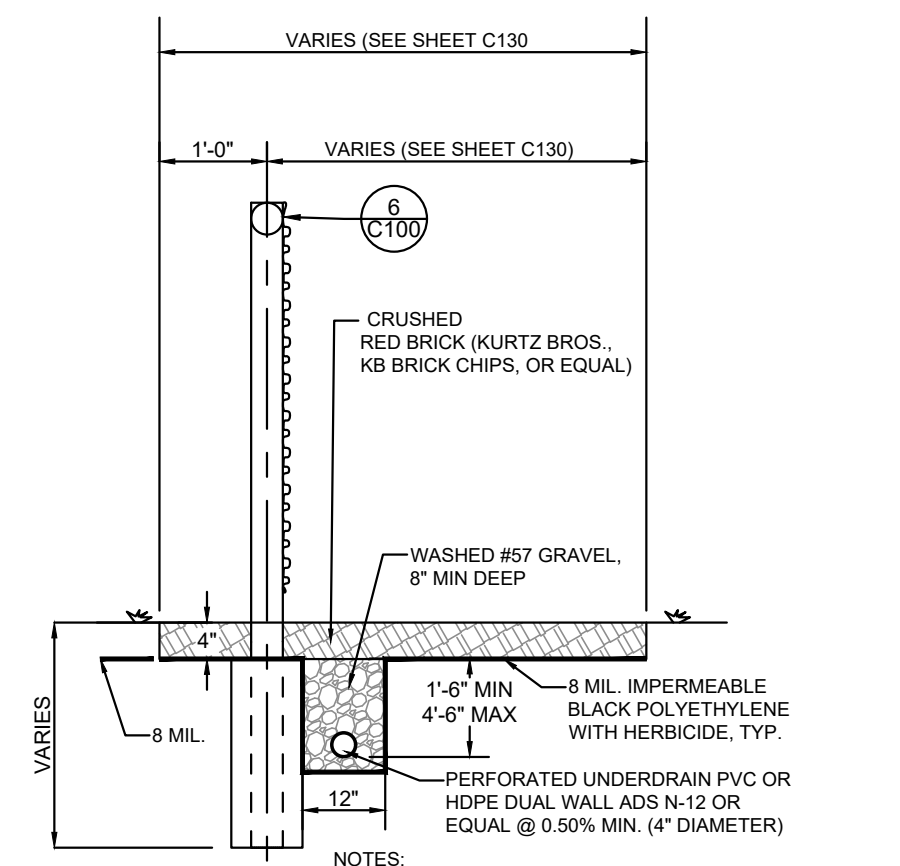


7 C100 WARNING TRACK N.T.S.

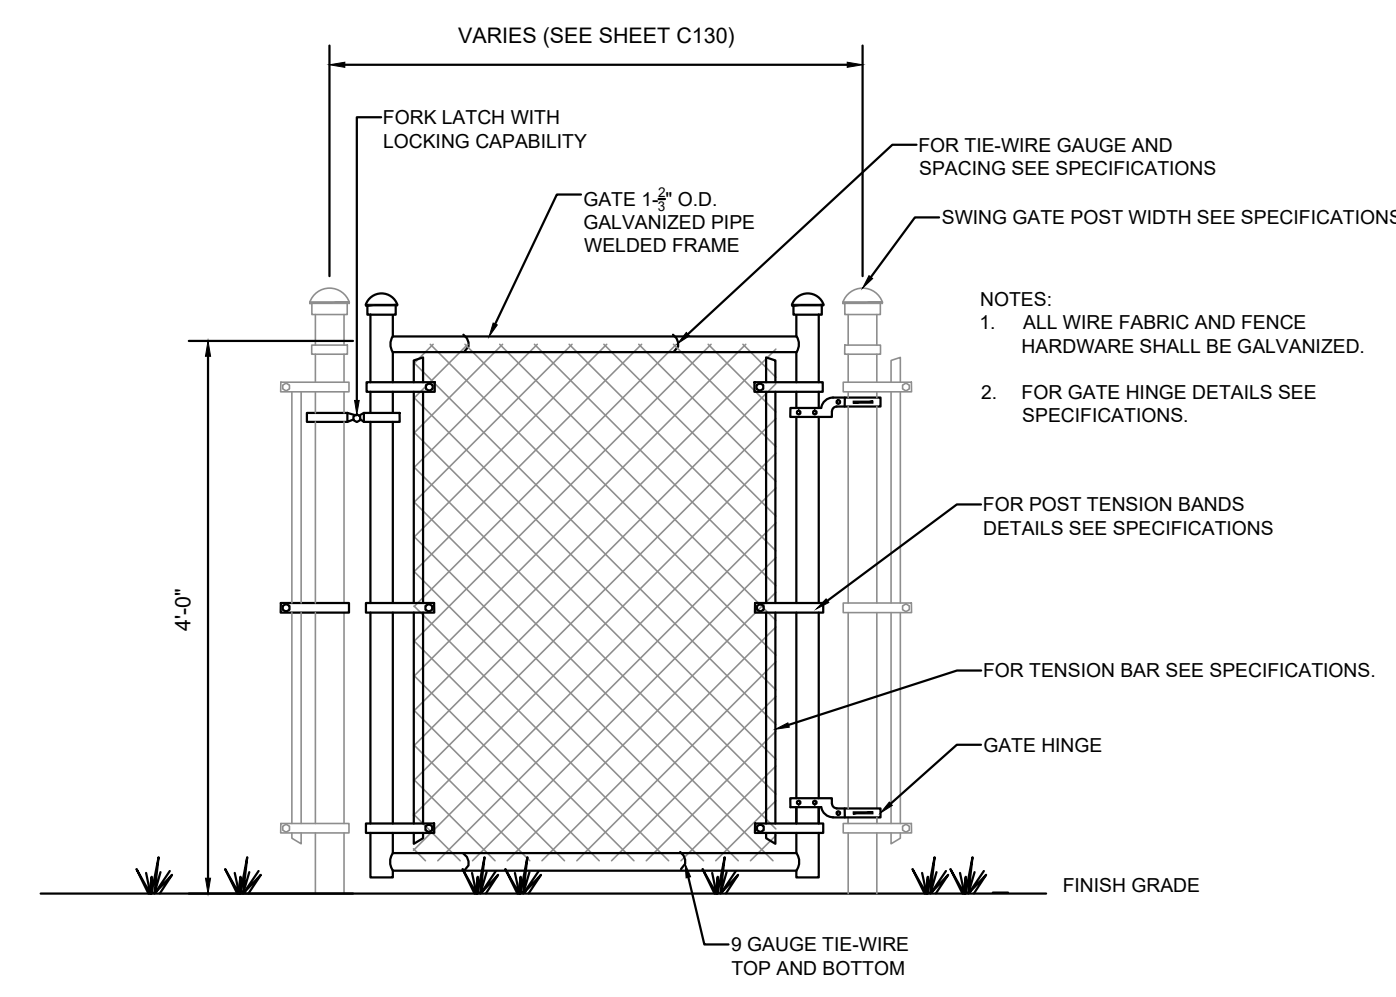


11 C100 4' VINYL COATED CHAIN LINK FENCE GATE DETAIL N.T.S.

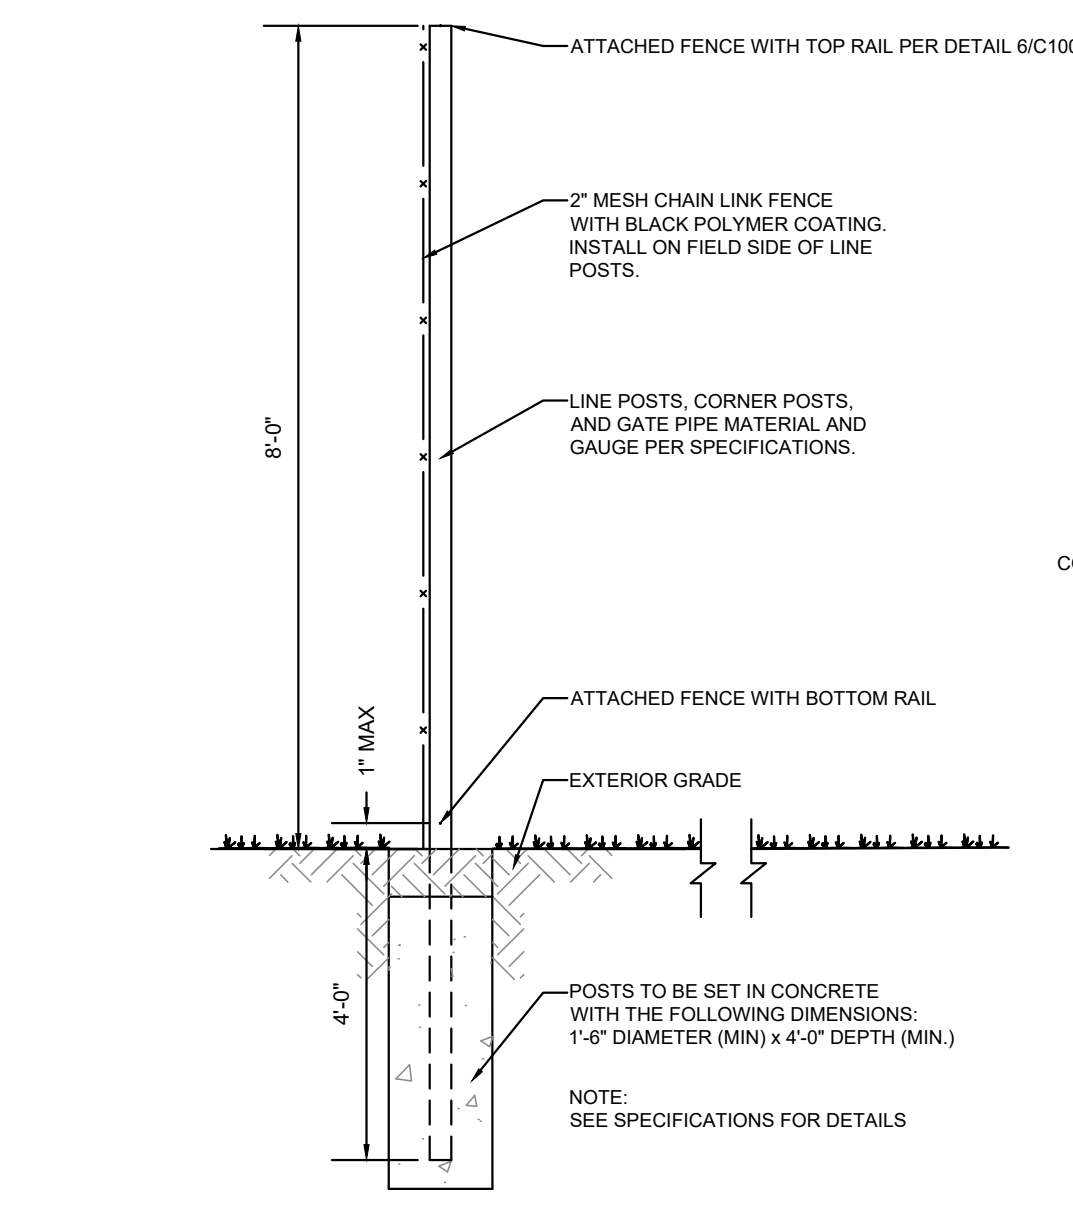


8 C100 8' VINYL COATED CHAIN LINK FENCE N.T.S.

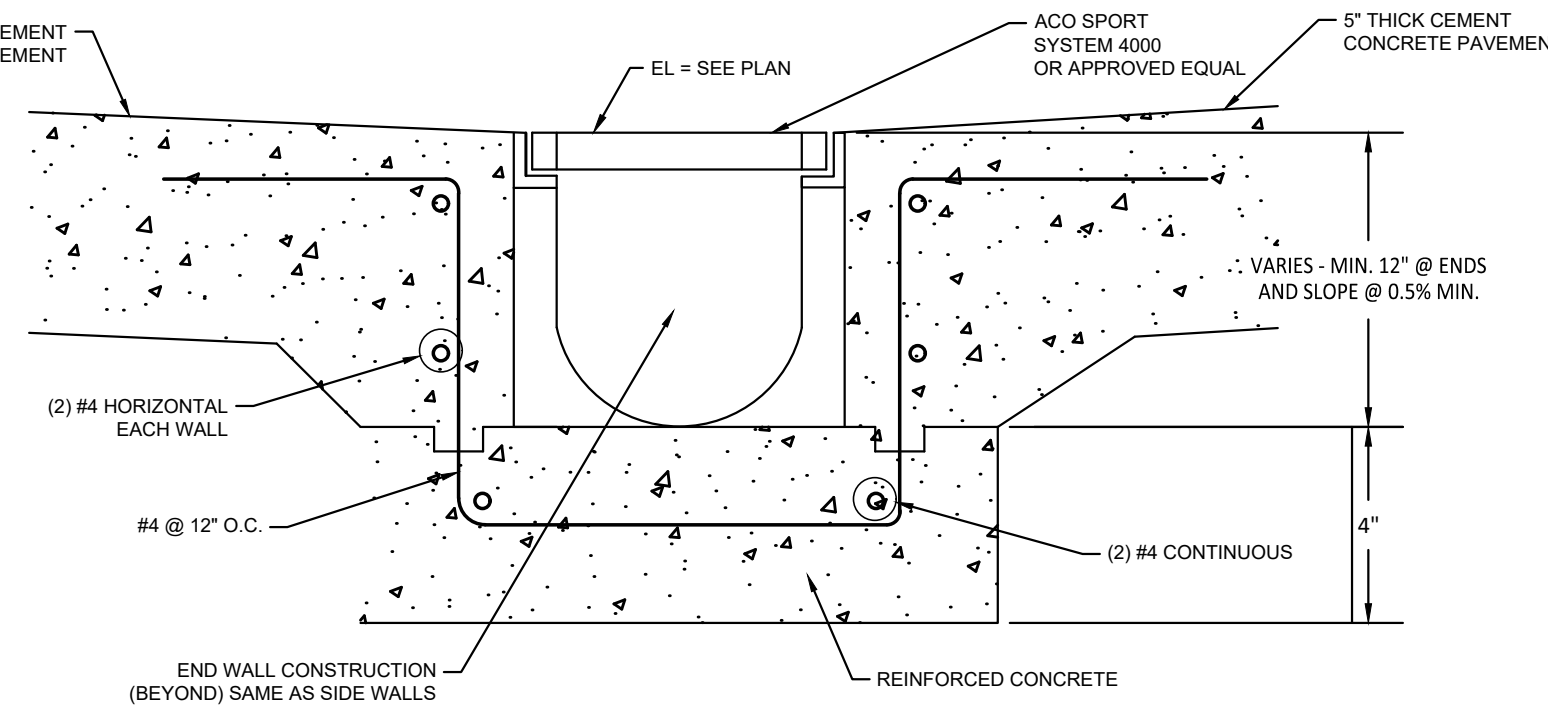

8 C100 TRENCH DRAIN DETAIL N.T.S.

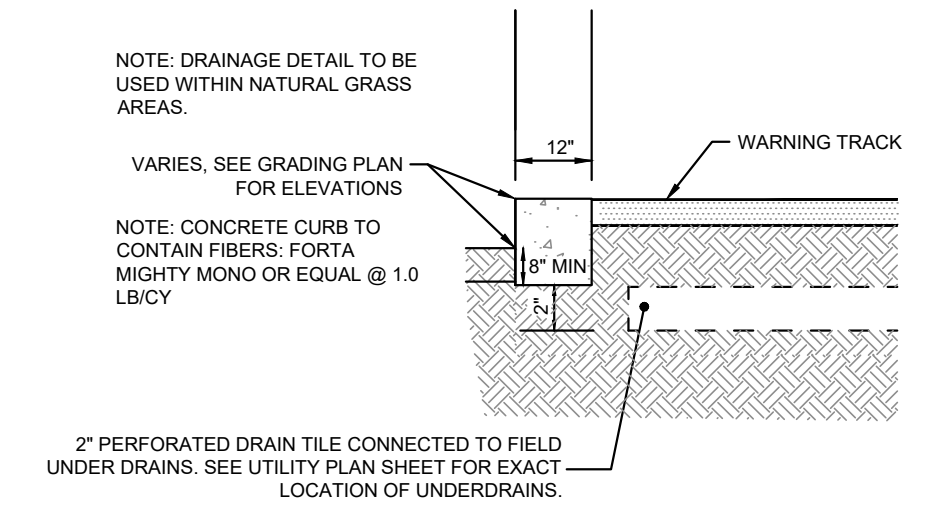

12 C100 PERIMETER CURB N.T.S.

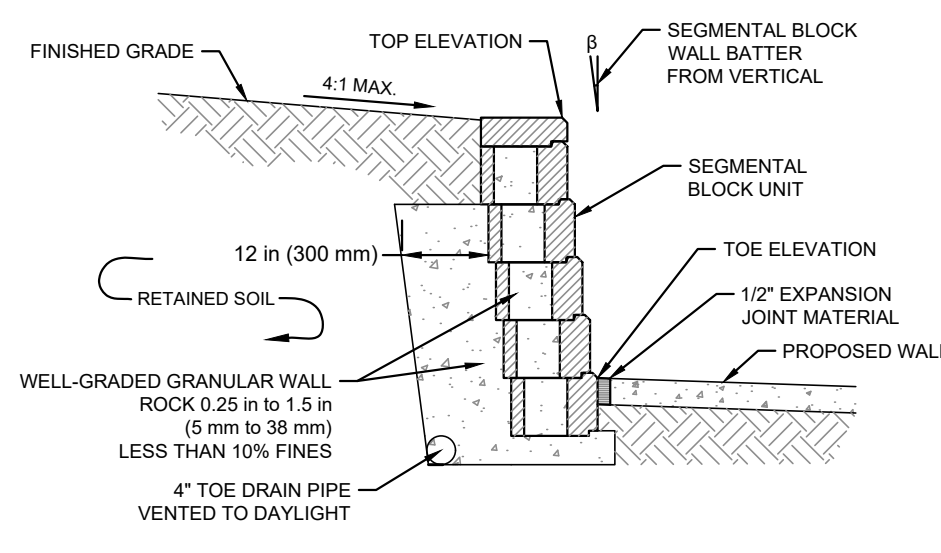

13 C100 SEGMENTAL RETAINING WALL DETAIL N.T.S.



NORTHERN KENTUCKY UNIVERSITY FRANK IGNATIUS GREIN SOFTBALL FIELD RENOVATIONS

SEAL:	
-------	--

NO.	DATE	DESCRIPTION
1	04/30/2021	FOR BID


NKU SOFTBALL FIELD RENOVATIONS
CITY OF HIGHLAND HEIGHTS
CAMPBELL COUNTY
COMMONWEALTH OF KENTUCKY

PROJECT NO:	080115.036
DATE:	APRIL 2021
SCALE:	
SHEET NAME:	

GENERAL NOTES & DETAILS

SHEET NO.	
-----------	--

C100

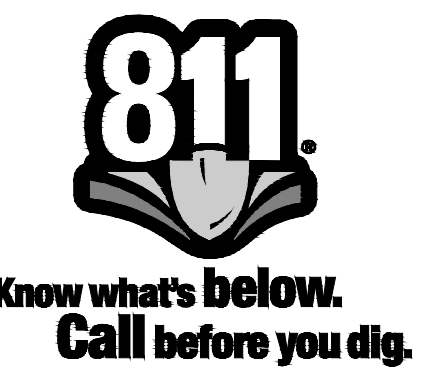

- SUBMIT SAMPLES OF WALL AND CAP UNITS FOR ENGINEER'S APPROVAL.
- CONSTRUCT FIELD MOCK-UP PRIOR TO INSTALLATION FOR ENGINEER'S APPROVAL AS SPECIFIED.
- CONSTRUCT WALLS PER MANUFACTURER'S SPECIFICATIONS.
- SEE SHEET C150 FOR WALL GRADES.

**NORTHERN KENTUCKY UNIVERSITY
FRANK IGNATIUS GREIN SOFTBALL
FIELD RENOVATIONS**

SEAL:


NO.	DATE	DESCRIPTION
1	04/30/2021	FOR BID

**NKU SOFTBALL
FIELD
RENOVATIONS**
CITY OF HIGHLAND HEIGHTS
CAMPBELL COUNTY
COMMONWEALTH OF KENTUCKY

PROJECT NO: 080115.036

DATE: APRIL 2021

SCALE:


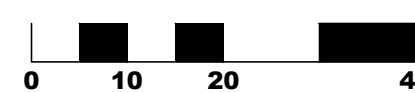


SHEET NAME:

SURVEY BASEMAP

SHEET NO.

C110

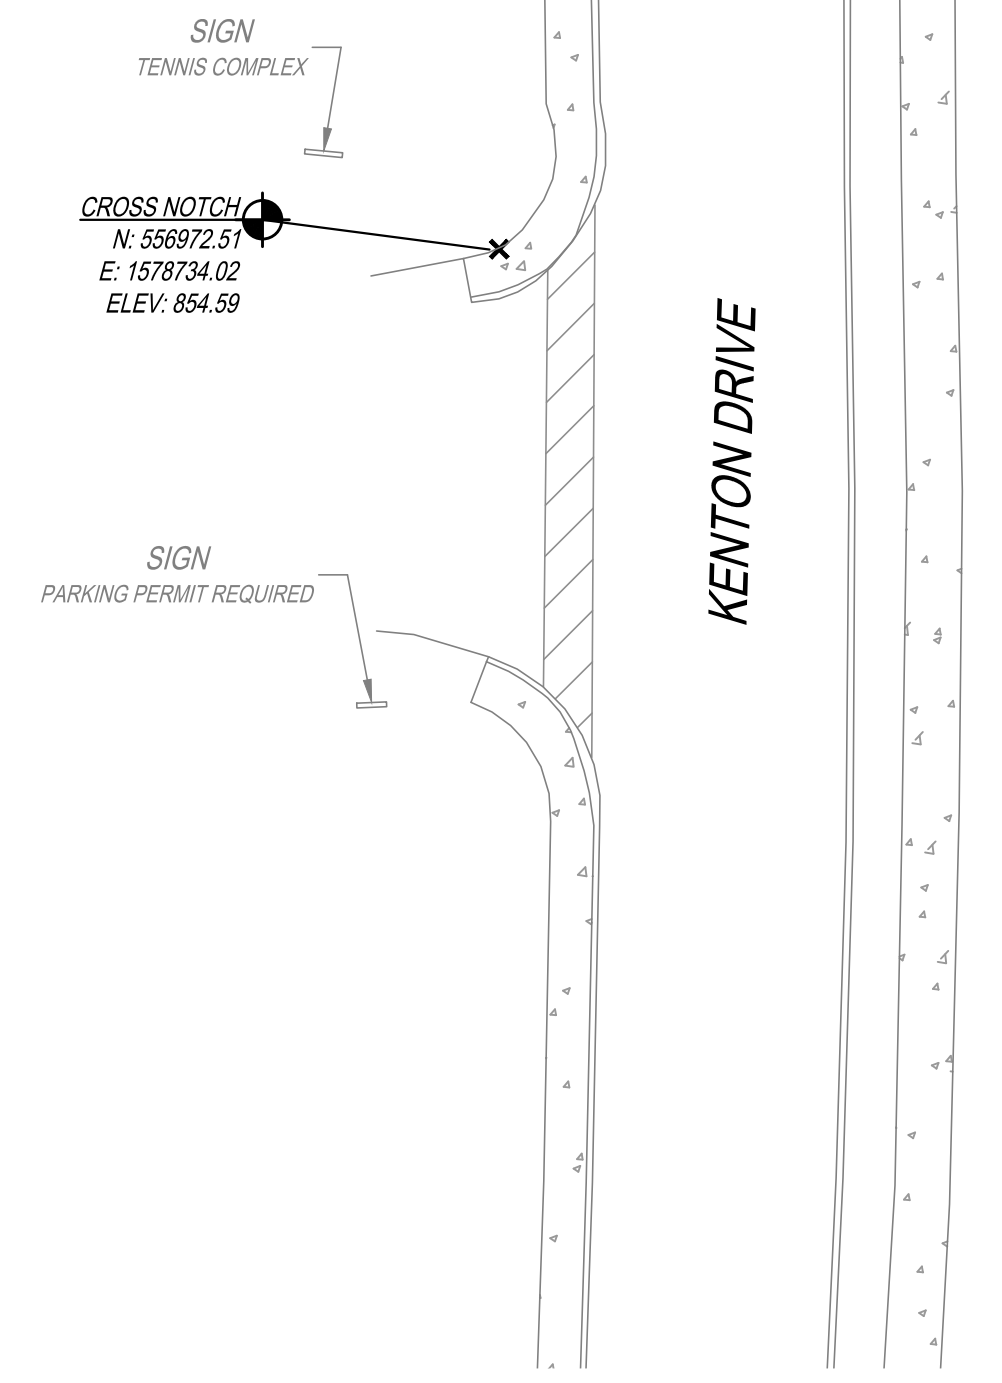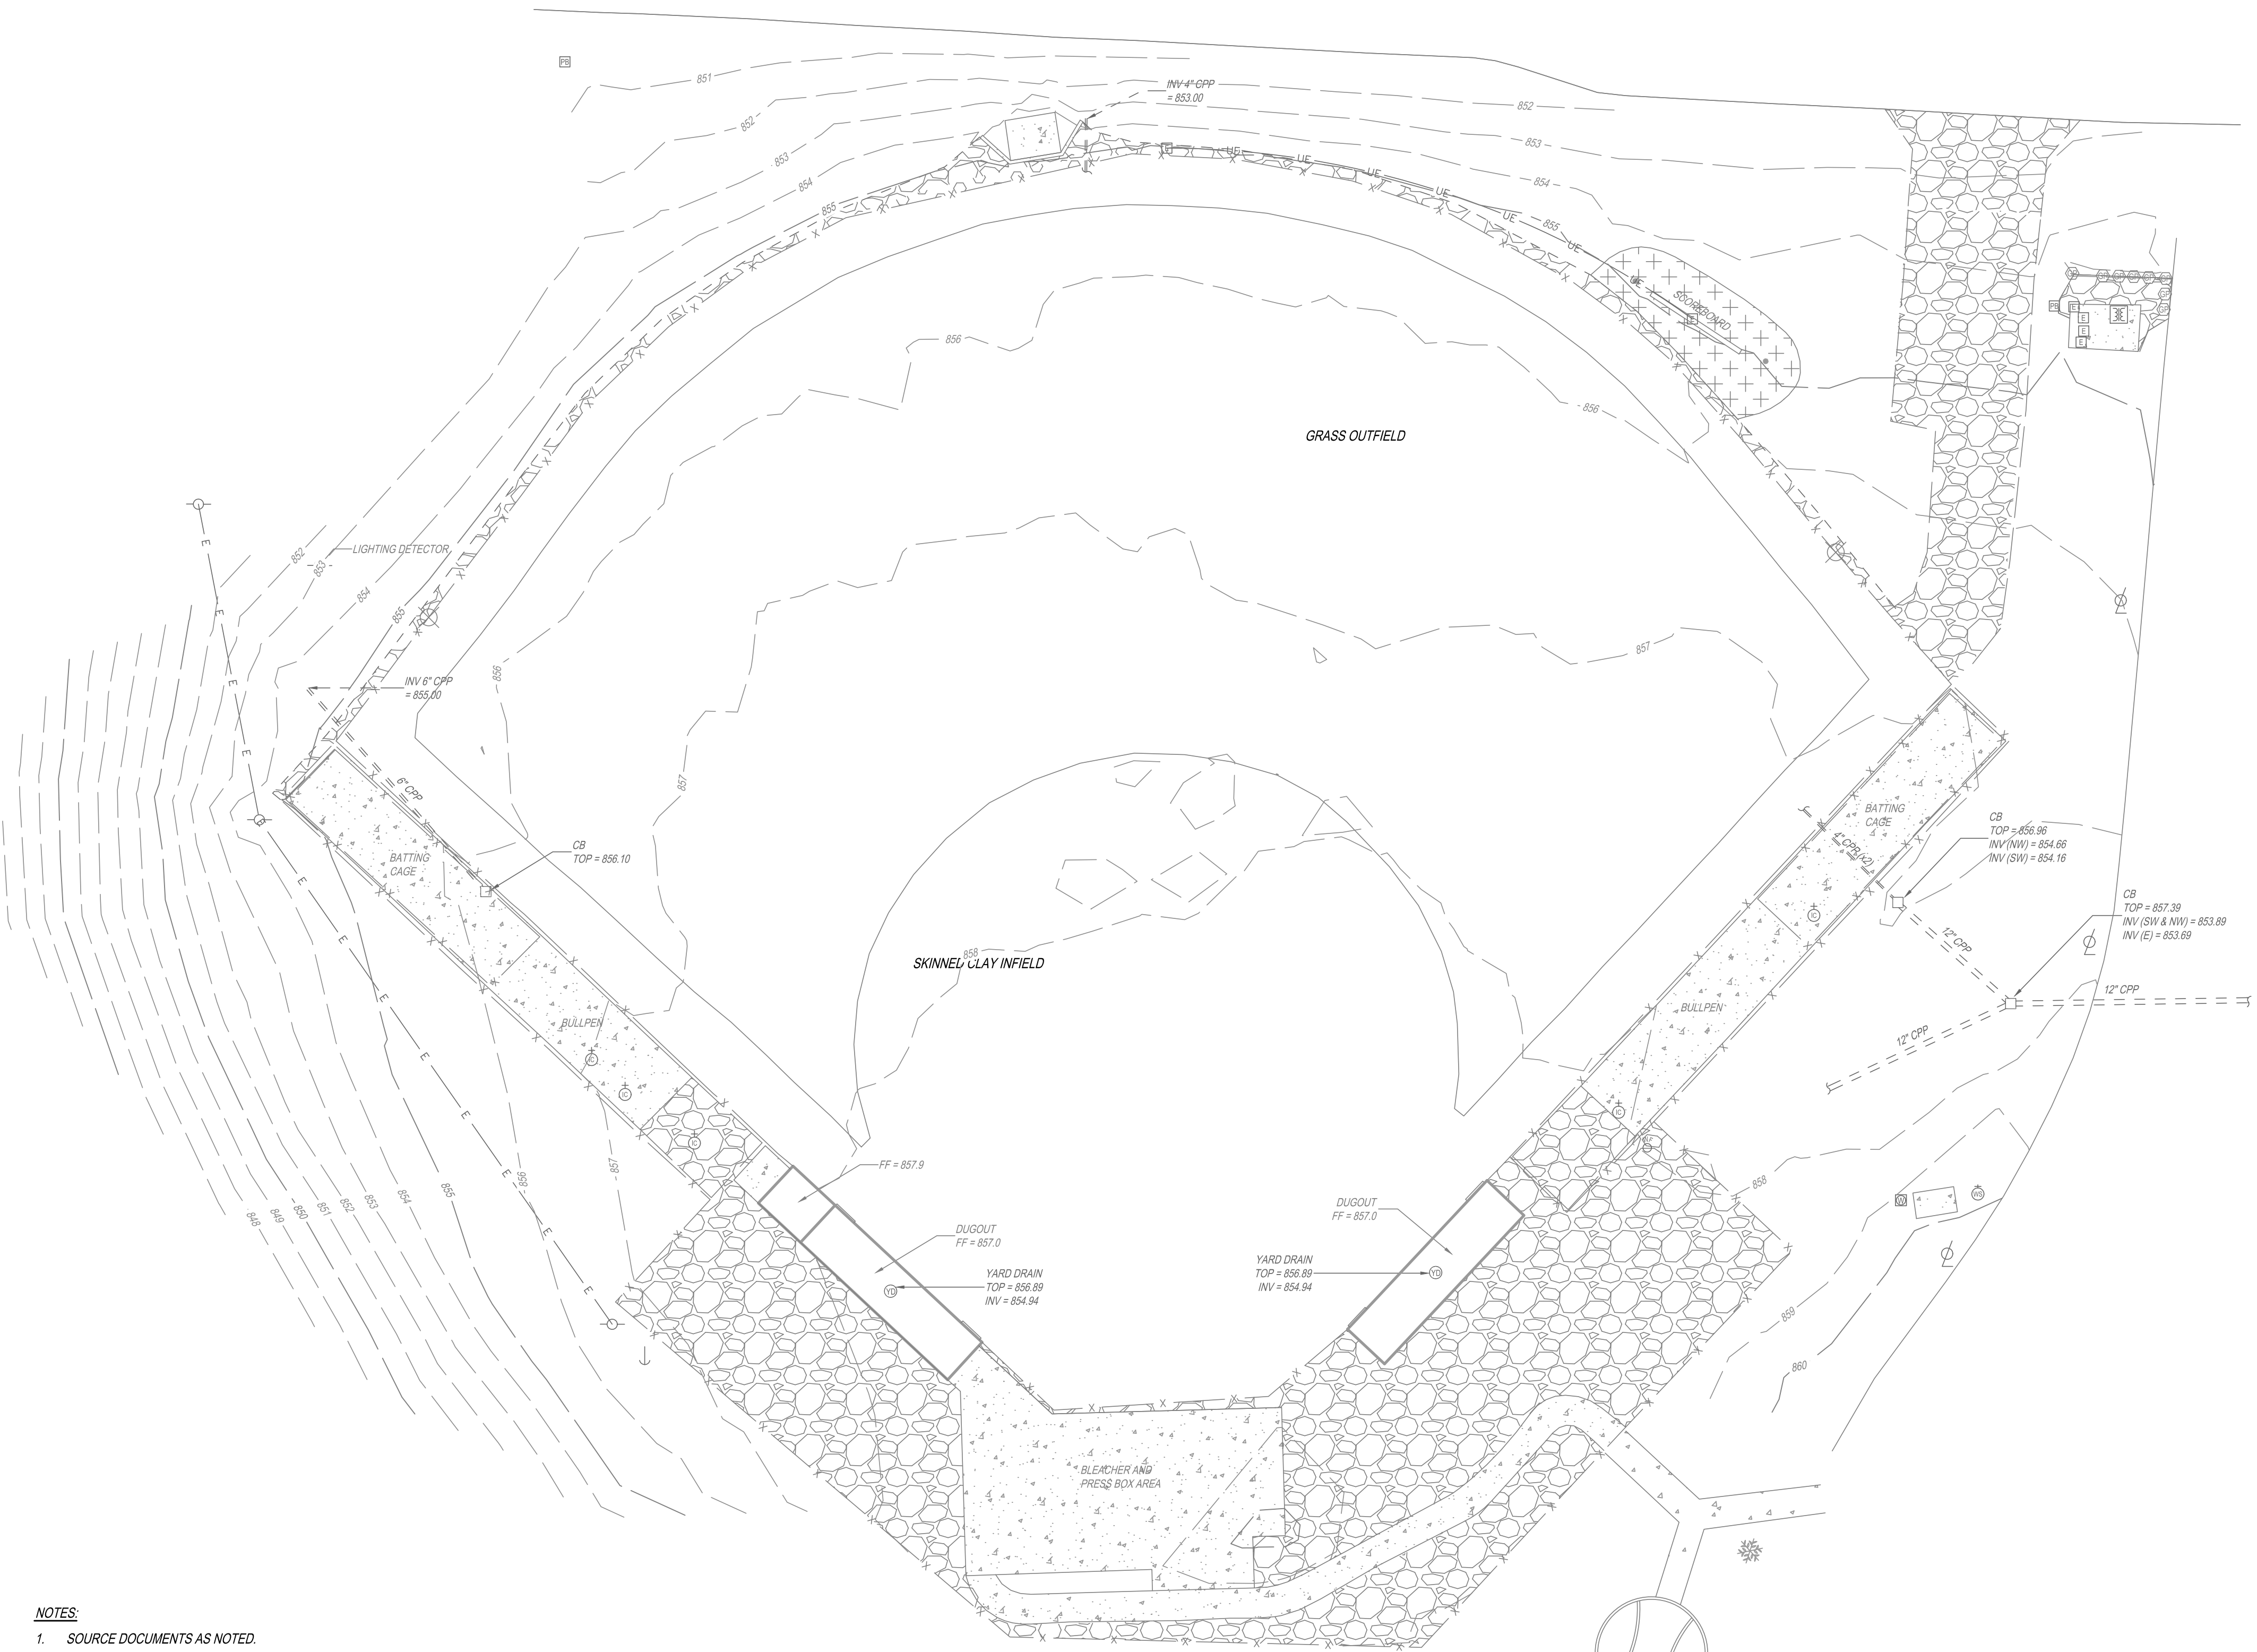

LEGEND

- SITE BENCHMARK
- ELECTRIC BOX
- ELECTRIC METER
- PULL BOX
- UNDERGROUND TRANSFORMER
- LIGHT POLE
- UTILITY POLE
- GUY WIRE
- CATCH BASIN
- STORM MANHOLE
- YARD DRAIN
- IRRIGATION CONTROL VALVE
- SPRINKLER HEAD
- WATER METER
- WATER SERVICE
- WATER FOUNTAIN
- GUARD POST
- CONIFEROUS TREE
- FENCE LINE
- OVERHEAD ELECTRIC
- UNDERGROUND ELECTRIC
- WATER
- STORM SEWER
- CONCRETE AREA
- GRAVEL AREA
- LANDSCAPED AREA
- RIP RAP AREA

NOTES:

1. SOURCE DOCUMENTS AS NOTED.
2. OCCUPATION IN GENERAL FITS SURVEY.
3. MONUMENTATION IS IN GOOD CONDITION UNLESS OTHERWISE NOTED.
4. HORIZONTAL AND VERTICAL DATUM ARE BASED ON THE KENTUCKY STATE PLANE COORDINATE SYSTEM NORTH ZONE (KSPC) AS DERIVED FROM THE KENTUCKY DEPARTMENT OF TRANSPORTATION'S VIRTUAL REFERENCE STATIONING (VRS) (NAD83) (NAVD88)
5. SITE BENCHMARK AS SHOWN HEREON.


NOTE:
UNDERGROUND UTILITIES ARE PLOTTED FROM A COMPILATION OF AVAILABLE RECORD INFORMATION AND SURFACE INDICATIONS OF UNDERGROUND STRUCTURES AND MAY NOT BE INCLUSIVE. PRECISE LOCATIONS AND THE EXISTENCE OR NON EXISTENCE OF UNDERGROUND UTILITIES CANNOT BE VERIFIED. PLEASE NOTIFY THE KENTUCKY UTILITY PROTECTION SERVICE AT 1-800-732-8007 BEFORE ANY PERIOD OF EXCAVATION OR CONSTRUCTION ACTIVITY.



Know what's below.
Call before you dig.

IRON PIN
N: 556603.55
E: 1578504.27

JOHNS HILL ROAD

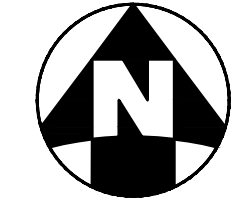

**NORTHERN KENTUCKY UNIVERSITY
FRANK IGNATIUS GREIN SOFTBALL
FIELD RENOVATIONS**

SEAL:

NO.	DATE	DESCRIPTION
1	04/30/2021	FOR BID

**NKU SOFTBALL
FIELD
RENOVATIONS**
CITY OF HIGHLAND HEIGHTS
CAMPBELL COUNTY
COMMONWEALTH OF KENTUCKY

PROJECT NO: 080115.036

DATE: APRIL 2021

SCALE:





SHEET NAME:

**SUPPLEMENTARY
SURVEY BASEMAP**

SHEET NO.

C111

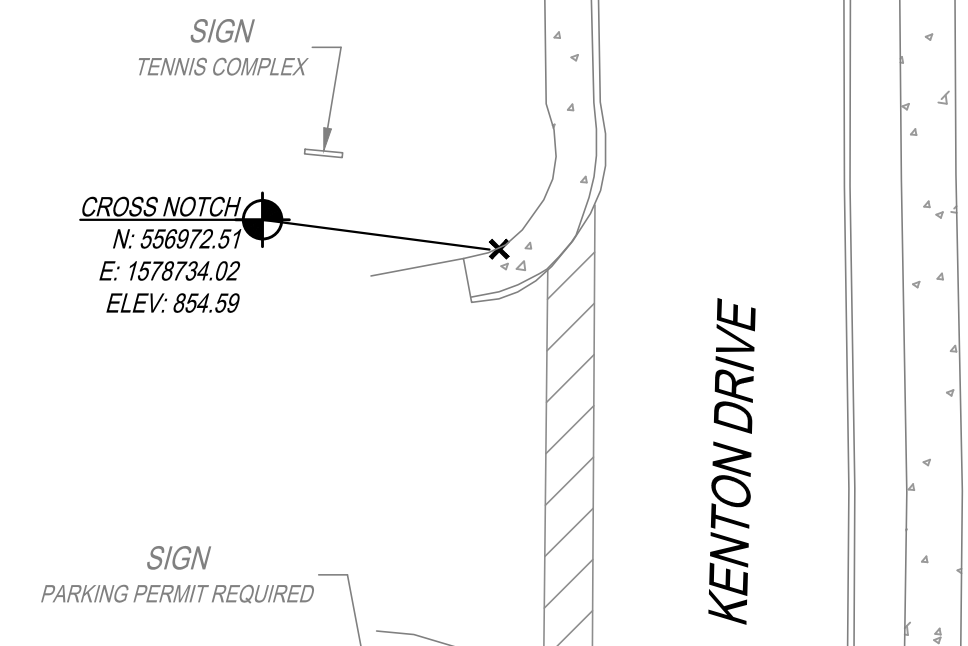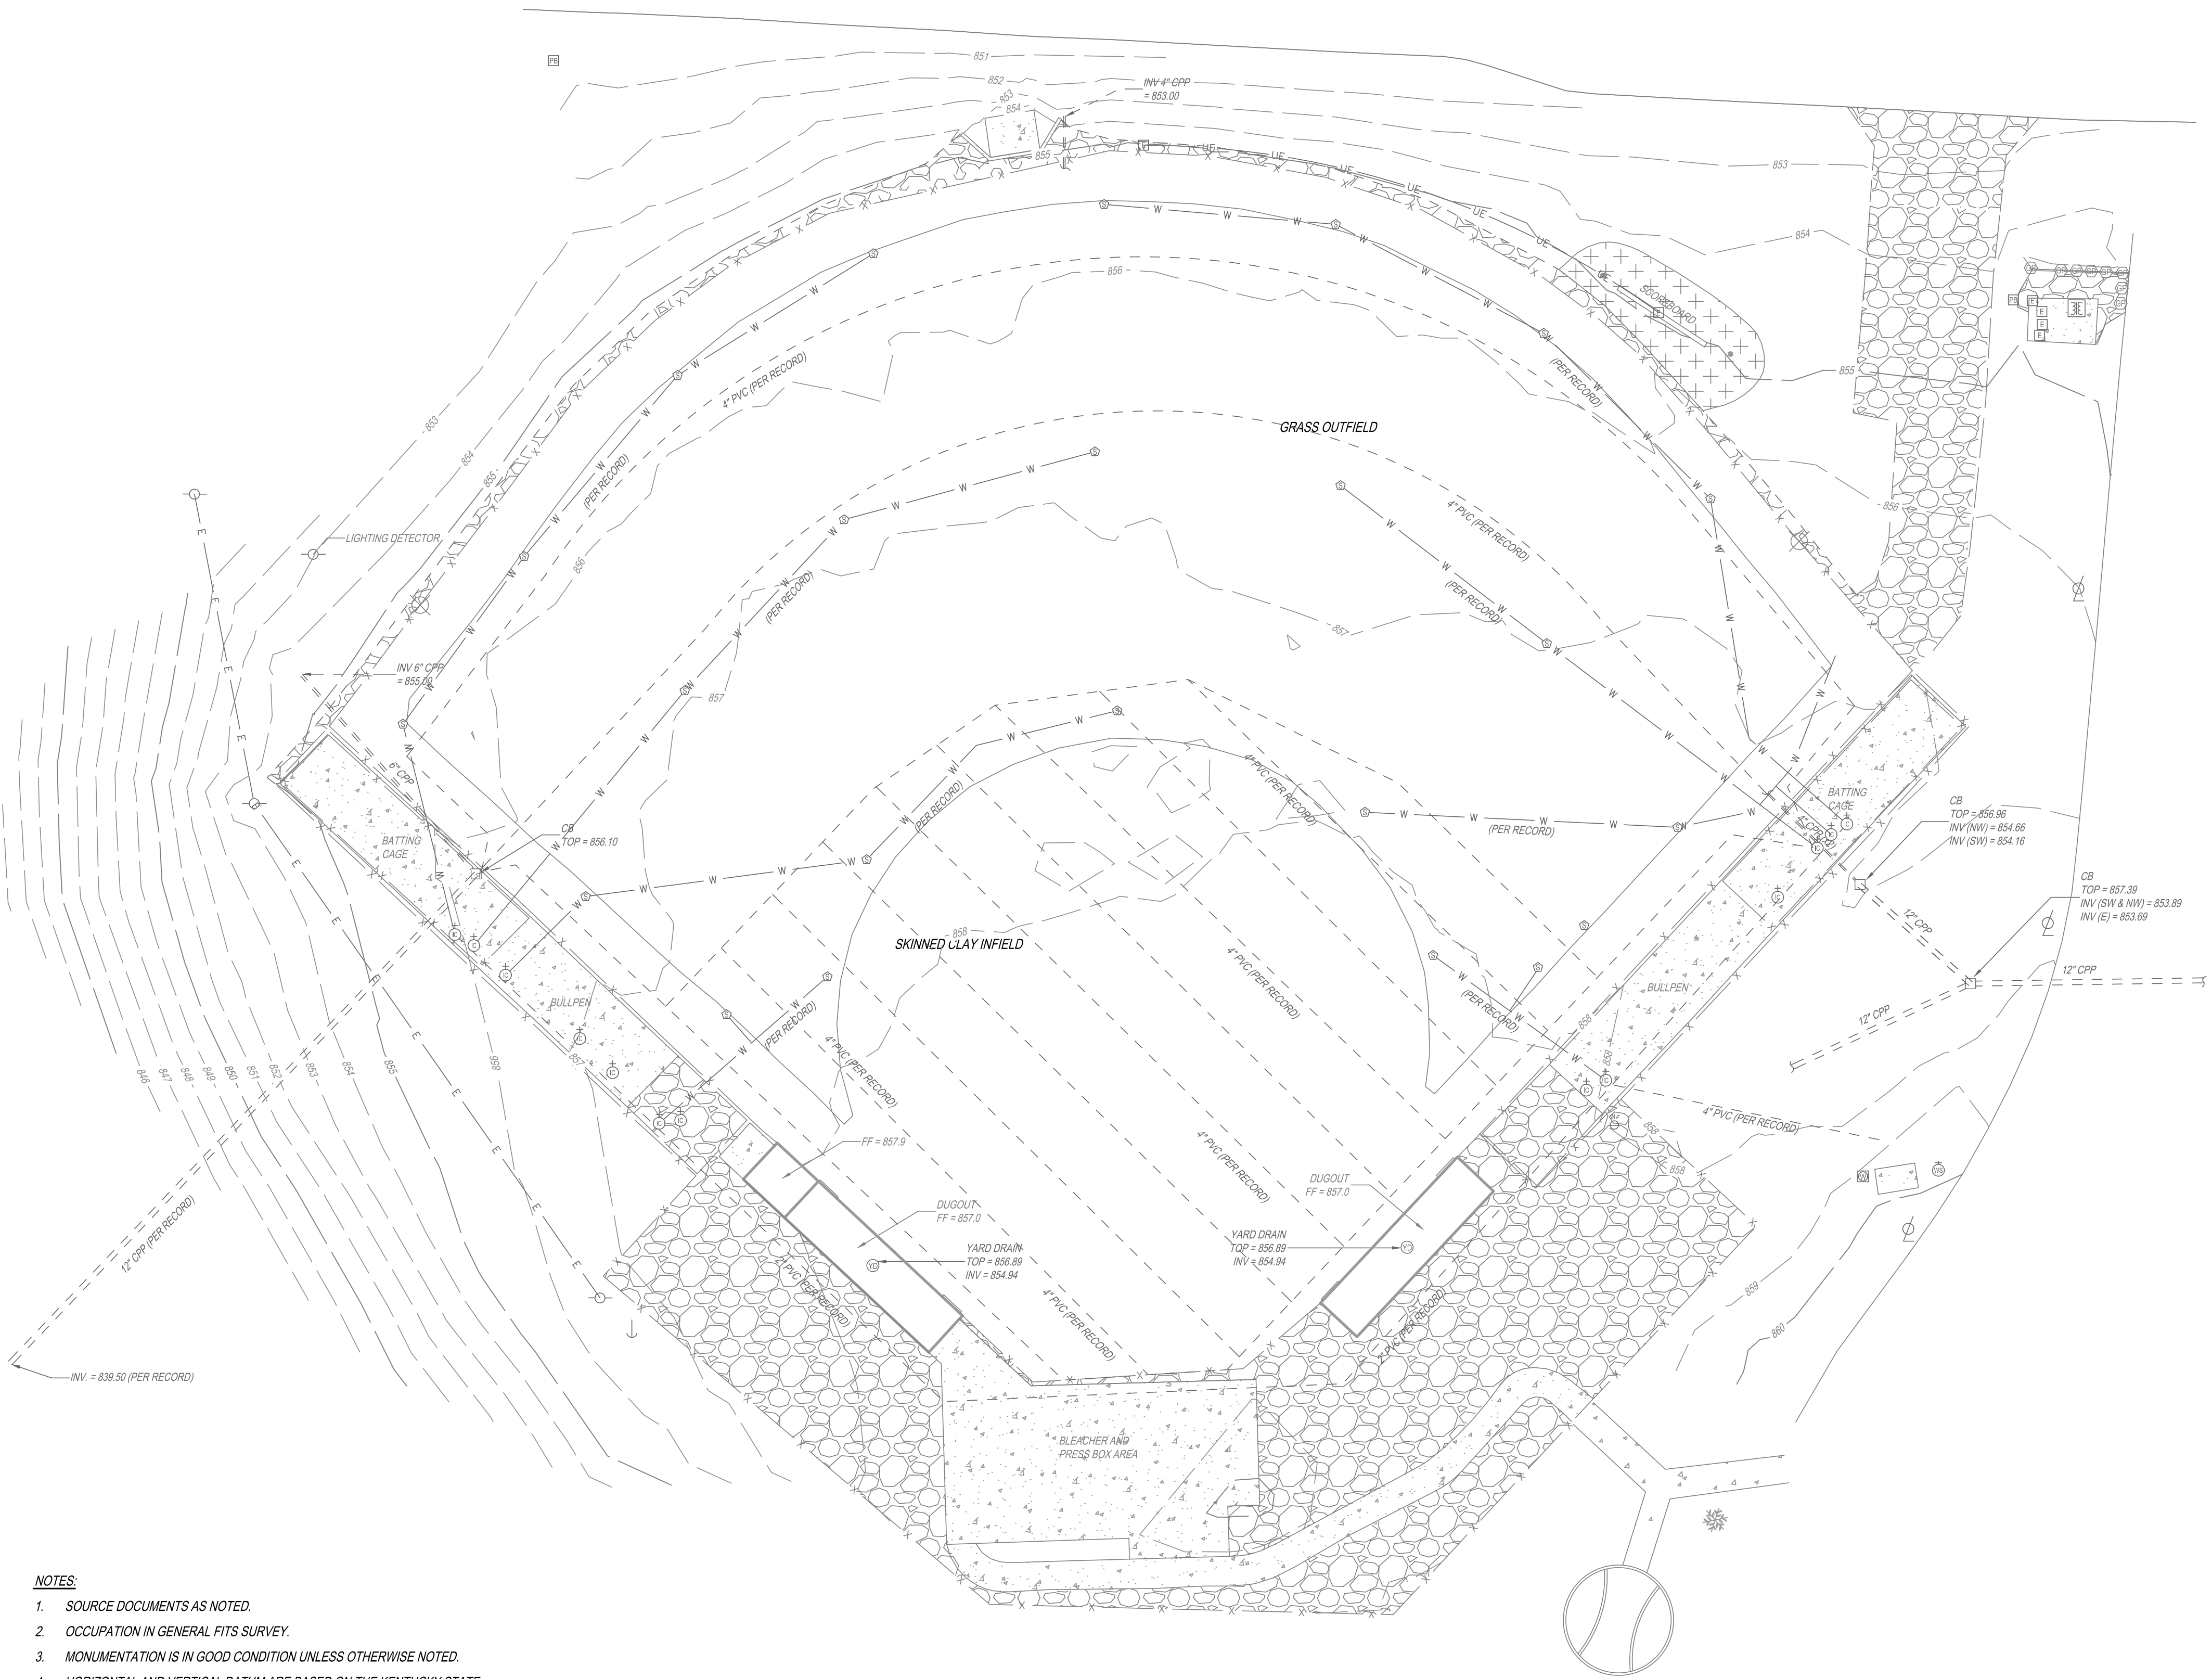


- LEGEND**
- SITE BENCHMARK
 - ELECTRIC BOX
 - ELECTRIC METER
 - PULL BOX
 - UNDERGROUND TRANSFORMER
 - LIGHT POLE
 - UTILITY POLE
 - GUY WIRE
 - CATCH BASIN
 - STORM MANHOLE
 - YARD DRAIN
 - IRRIGATION CONTROL VALVE
 - SPRINKLER HEAD
 - WATER METER
 - WATER SERVICE
 - WATER FOUNTAIN
 - GUARD POST
 - CONIFEROUS TREE
 - FENCE LINE
 - OVERHEAD ELECTRIC
 - UNDERGROUND ELECTRIC
 - WATER
 - STORM SEWER
 - CONCRETE AREA
 - GRAVEL AREA
 - LANDSCAPED AREA
 - RIP RAP AREA

- NOTES:**
- SOURCE DOCUMENTS AS NOTED.
 - OCCUPATION IN GENERAL FITS SURVEY.
 - MONUMENTATION IS IN GOOD CONDITION UNLESS OTHERWISE NOTED.
 - HORIZONTAL AND VERTICAL DATUM ARE BASED ON THE KENTUCKY STATE PLANE COORDINATE SYSTEM NORTH ZONE (KSPC) AS DERIVED FROM THE KENTUCKY DEPARTMENT OF TRANSPORTATION'S VIRTUAL REFERENCE STATIONING (VRS) (NAD83) (NAVD88).
 - SITE BENCHMARK AS SHOWN HEREON.

NOTE:
UNDERGROUND UTILITIES ARE PLOTTED FROM A COMPILATION OF AVAILABLE RECORD INFORMATION AND SURFACE INDICATIONS OF UNDERGROUND STRUCTURES AND MAY NOT BE INCLUSIVE. PRECISE LOCATIONS AND THE EXISTENCE OR NON EXISTENCE OF UNDERGROUND UTILITIES CANNOT BE VERIFIED. PLEASE NOTIFY THE KENTUCKY UTILITY PROTECTION SERVICE AT 1-800-752-8007 BEFORE ANY PERIOD OF EXCAVATION OR CONSTRUCTION ACTIVITY.



Know what's below.
Call before you dig.

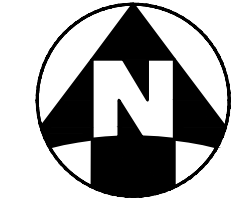

IRON PIN
N: 556603.55
E: 1578504.27

JOHNS HILL ROAD

KENTON DRIVE

NORTHERN KENTUCKY UNIVERSITY
FRANK IGNATIUS GREIN SOFTBALL
FIELD RENOVATIONS

SEAL:


NO.	DATE	DESCRIPTION
1	04/30/2021	FOR BID

**NKU SOFTBALL
FIELD
RENOVATIONS**
CITY OF HIGHLAND HEIGHTS
CAMPBELL COUNTY
COMMONWEALTH OF KENTUCKY

PROJECT NO: 080115.036

DATE: APRIL 2021

SCALE:

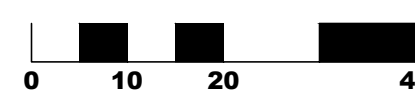


SHEET NAME:

DEMOLITION PLAN

SHEET NO.

C120

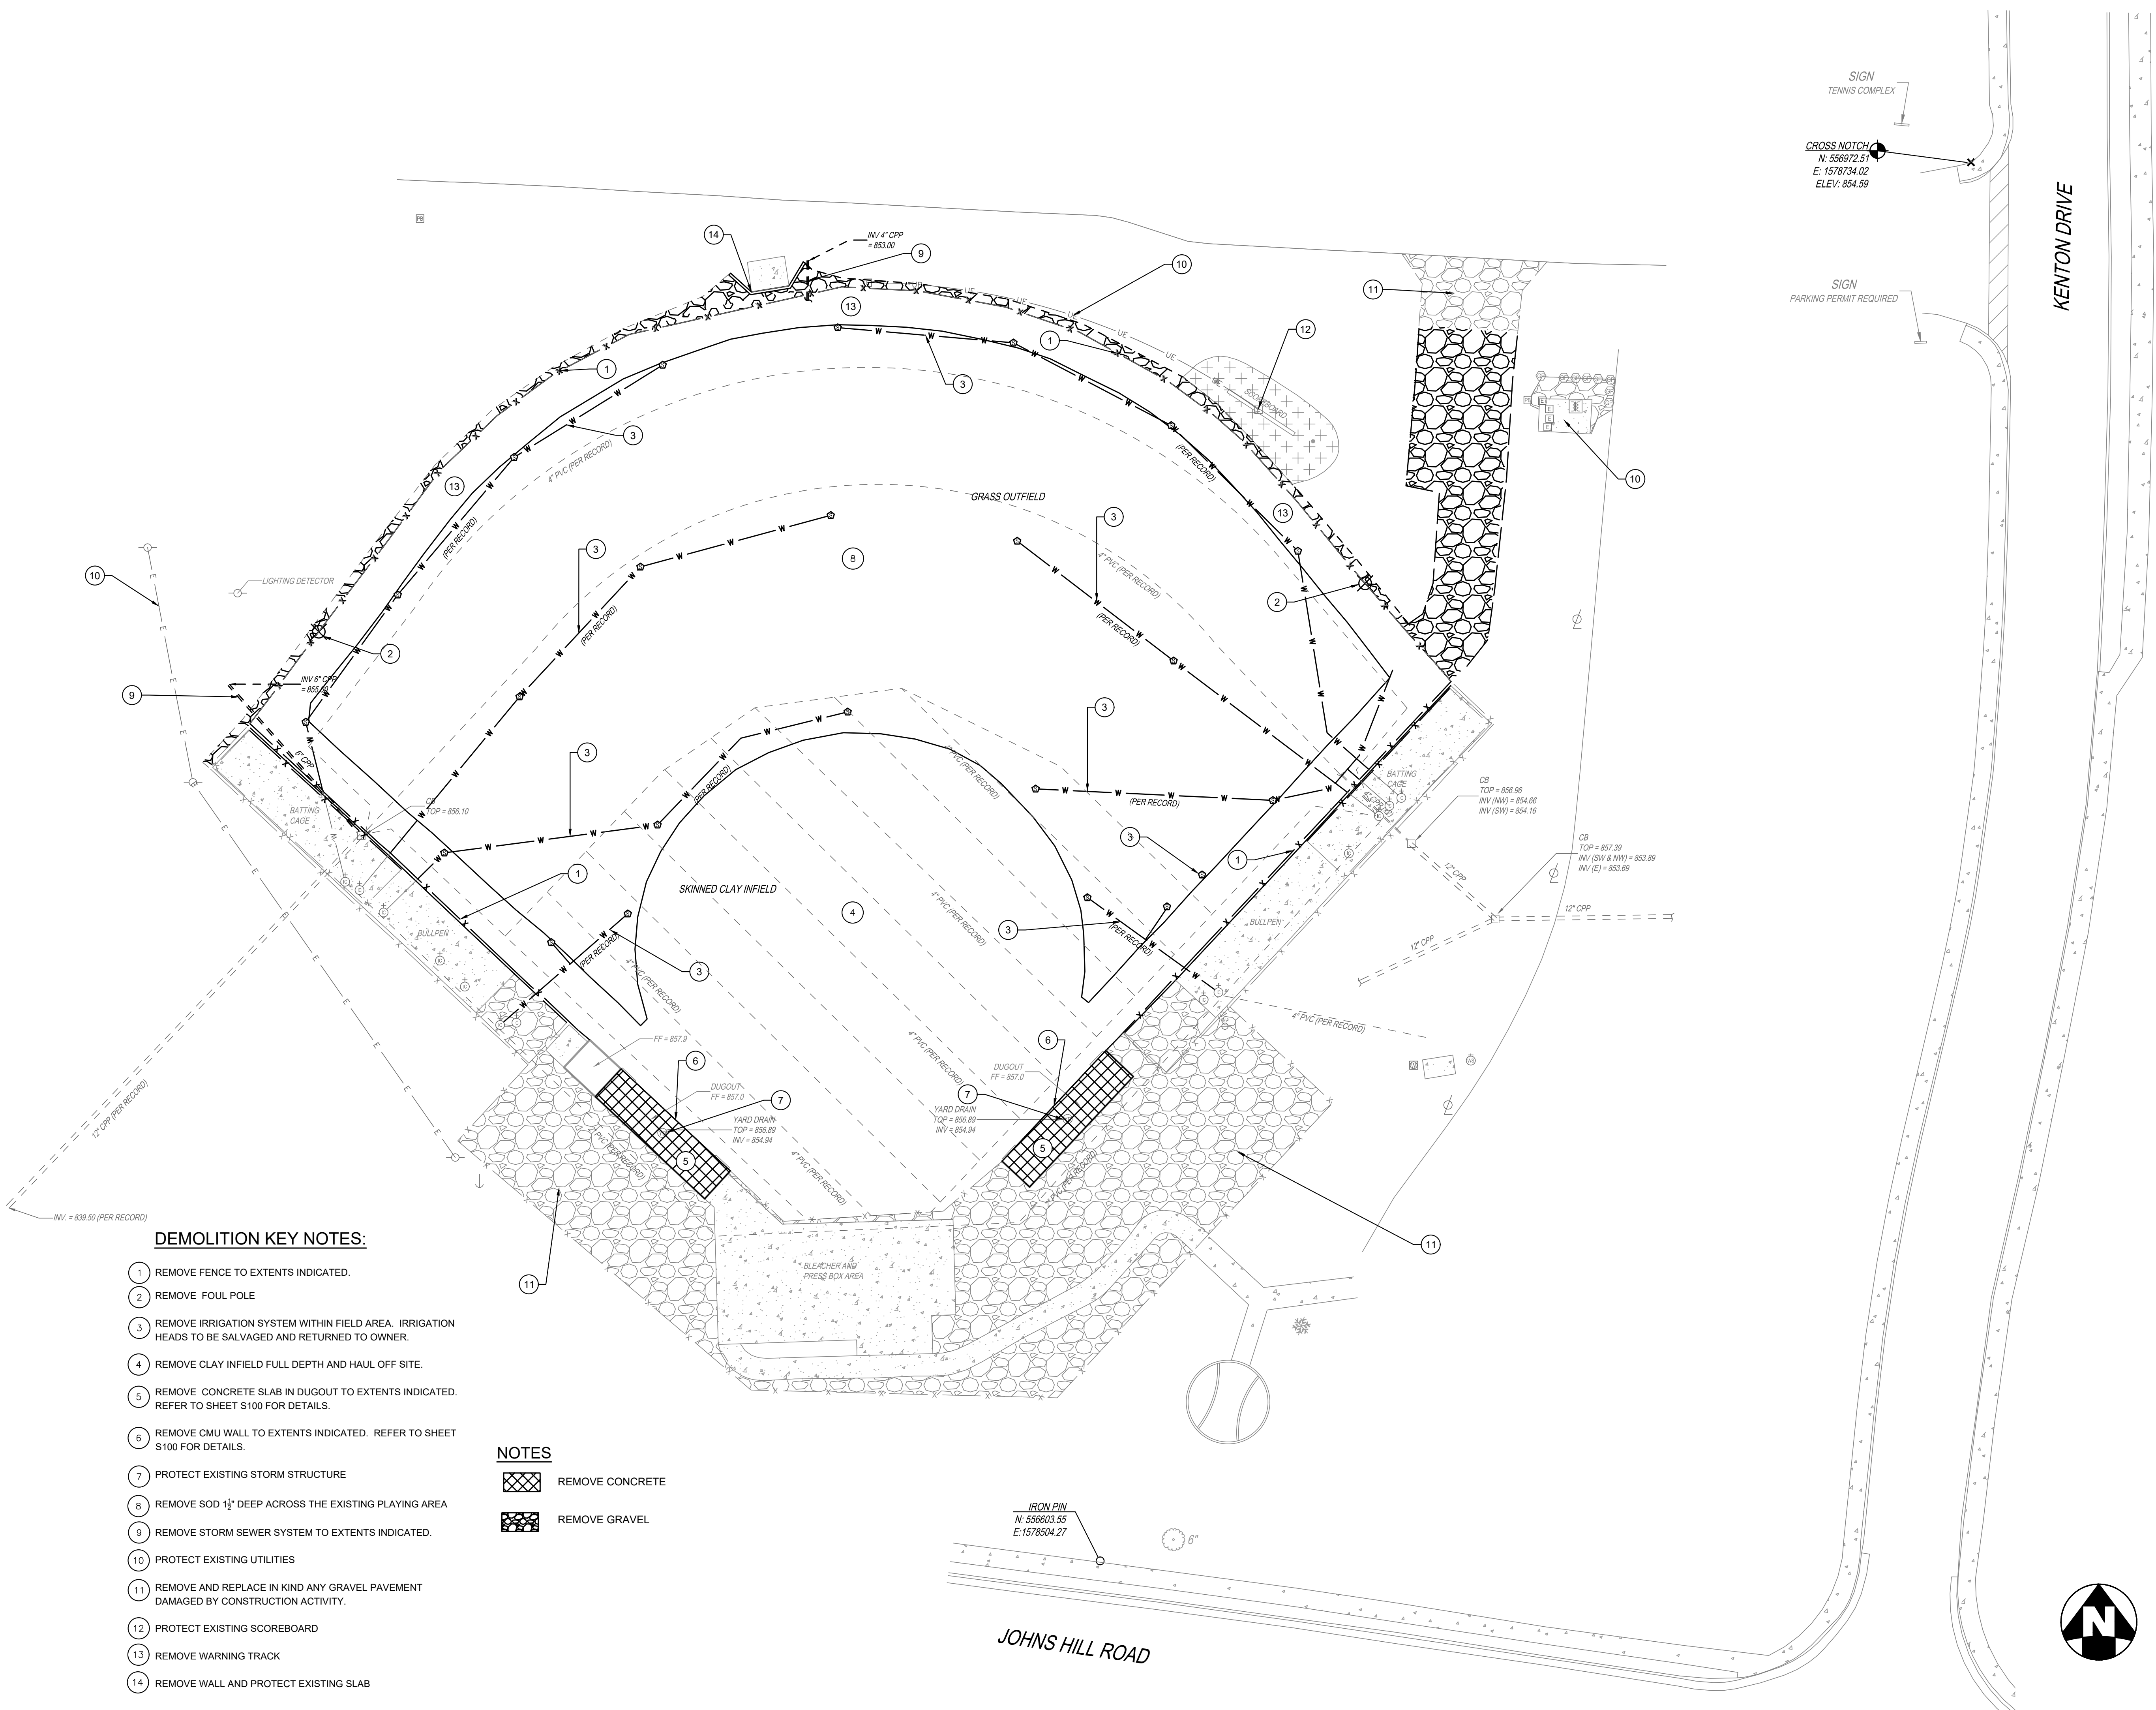

DEMOLITION KEY NOTES:


- 1 REMOVE FENCE TO EXTENTS INDICATED.
- 2 REMOVE FOUL POLE
- 3 REMOVE IRRIGATION SYSTEM WITHIN FIELD AREA. IRRIGATION HEADS TO BE SALVAGED AND RETURNED TO OWNER.
- 4 REMOVE CLAY INFIELD FULL DEPTH AND HAUL OFF SITE.
- 5 REMOVE CONCRETE SLAB IN DUGOUT TO EXTENTS INDICATED. REFER TO SHEET S100 FOR DETAILS.
- 6 REMOVE CMU WALL TO EXTENTS INDICATED. REFER TO SHEET S100 FOR DETAILS.
- 7 PROTECT EXISTING STORM STRUCTURE
- 8 REMOVE SOD 1 1/2" DEEP ACROSS THE EXISTING PLAYING AREA
- 9 REMOVE STORM SEWER SYSTEM TO EXTENTS INDICATED.
- 10 PROTECT EXISTING UTILITIES
- 11 REMOVE AND REPLACE IN KIND ANY GRAVEL PAVEMENT DAMAGED BY CONSTRUCTION ACTIVITY.
- 12 PROTECT EXISTING SCOREBOARD
- 13 REMOVE WARNING TRACK
- 14 REMOVE WALL AND PROTECT EXISTING SLAB

NOTES

- REMOVE CONCRETE
- REMOVE GRAVEL



Know what's below.
Call before you dig.

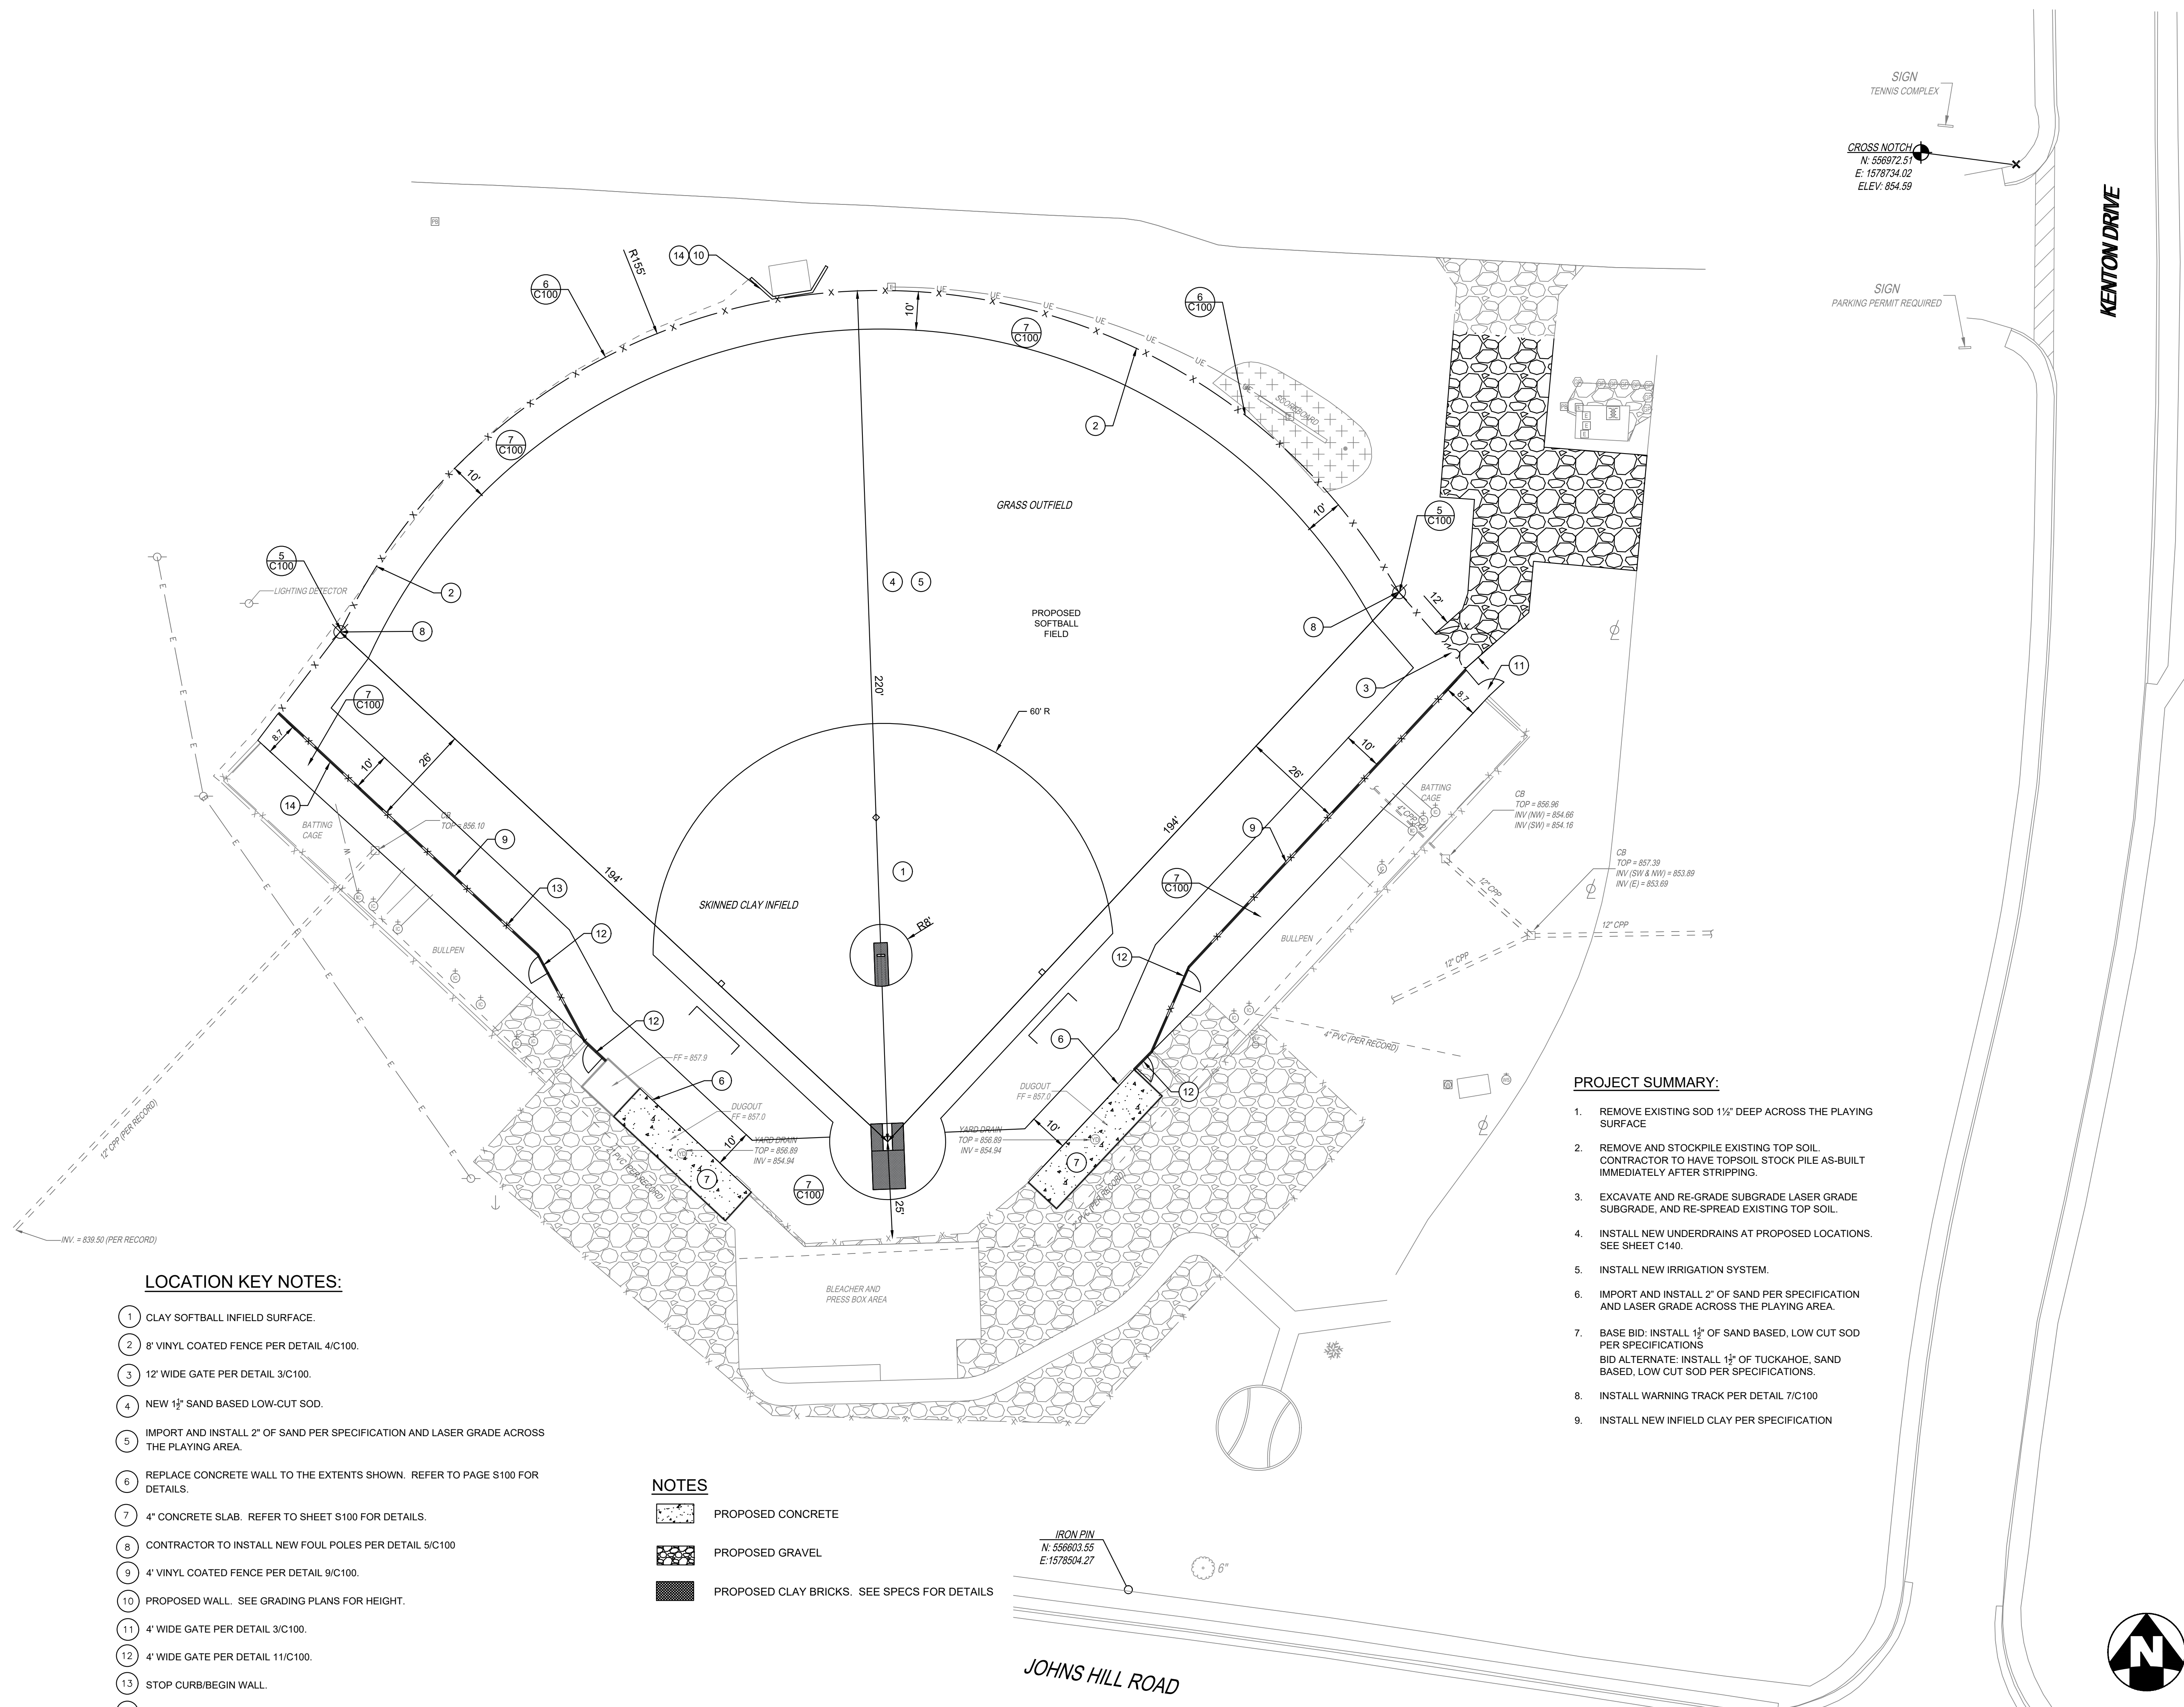

LOCATION KEY NOTES:

- 1 CLAY SOFTBALL INFIELD SURFACE.
- 2 8' VINYL COATED FENCE PER DETAIL 4/C100.
- 3 12' WIDE GATE PER DETAIL 3/C100.
- 4 NEW 1 1/2" SAND BASED LOW-CUT SOD.
- 5 IMPORT AND INSTALL 2" OF SAND PER SPECIFICATION AND LASER GRADE ACROSS THE PLAYING AREA.
- 6 REPLACE CONCRETE WALL TO THE EXTENTS SHOWN. REFER TO PAGE S100 FOR DETAILS.
- 7 4" CONCRETE SLAB. REFER TO SHEET S100 FOR DETAILS.
- 8 CONTRACTOR TO INSTALL NEW FOUL POLES PER DETAIL 5/C100
- 9 4' VINYL COATED FENCE PER DETAIL 9/C100.
- 10 PROPOSED WALL. SEE GRADING PLANS FOR HEIGHT.
- 11 4' WIDE GATE PER DETAIL 3/C100.
- 12 4' WIDE GATE PER DETAIL 11/C100.
- 13 STOP CURB/BEGIN WALL.
- 14 RETAINING WALL PER DETAIL 13/C100.

- NOTES**
- PROPOSED CONCRETE
 - PROPOSED GRAVEL
 - PROPOSED CLAY BRICKS. SEE SPECS FOR DETAILS

PROJECT SUMMARY:

1. REMOVE EXISTING SOD 1 1/2" DEEP ACROSS THE PLAYING SURFACE
2. REMOVE AND STOCKPILE EXISTING TOP SOIL. CONTRACTOR TO HAVE TOPSOIL STOCK PILE AS-BUILT IMMEDIATELY AFTER STRIPPING.
3. EXCAVATE AND RE-GRADE SUBGRADE LASER GRADE SUBGRADE, AND RE-SPREAD EXISTING TOP SOIL.
4. INSTALL NEW UNDERDRAINS AT PROPOSED LOCATIONS. SEE SHEET C140.
5. INSTALL NEW IRRIGATION SYSTEM.
6. IMPORT AND INSTALL 2" OF SAND PER SPECIFICATION AND LASER GRADE ACROSS THE PLAYING AREA.
7. BASE BID: INSTALL 1 1/2" OF SAND BASED, LOW CUT SOD PER SPECIFICATIONS
 BID ALTERNATE: INSTALL 1 1/2" OF TUCKAHOE, SAND BASED, LOW CUT SOD PER SPECIFICATIONS.
8. INSTALL WARNING TRACK PER DETAIL 7/C100
9. INSTALL NEW INFIELD CLAY PER SPECIFICATION




**NORTHERN KENTUCKY UNIVERSITY
FRANK IGNATIUS GREIN SOFTBALL
FIELD RENOVATIONS**

SEAL:

NO.	DATE	DESCRIPTION
1	04/30/2021	FOR BID

**NKU SOFTBALL
FIELD
RENOVATIONS**
CITY OF HIGHLAND HEIGHTS
CAMPBELL COUNTY
COMMONWEALTH OF KENTUCKY

PROJECT NO: 080115.036
DATE: APRIL 2021

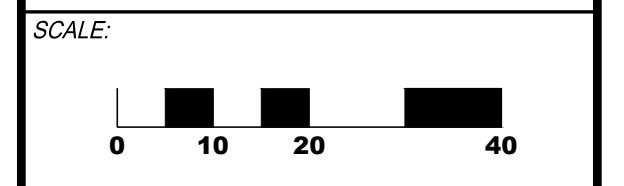

SHEET NAME:

LOCATION PLAN


SHEET NO.
C130

KENTON DRIVE

JOHNS HILL ROAD



NORTHERN KENTUCKY UNIVERSITY
FRANK IGNATIUS GREIN SOFTBALL
FIELD RENOVATIONS

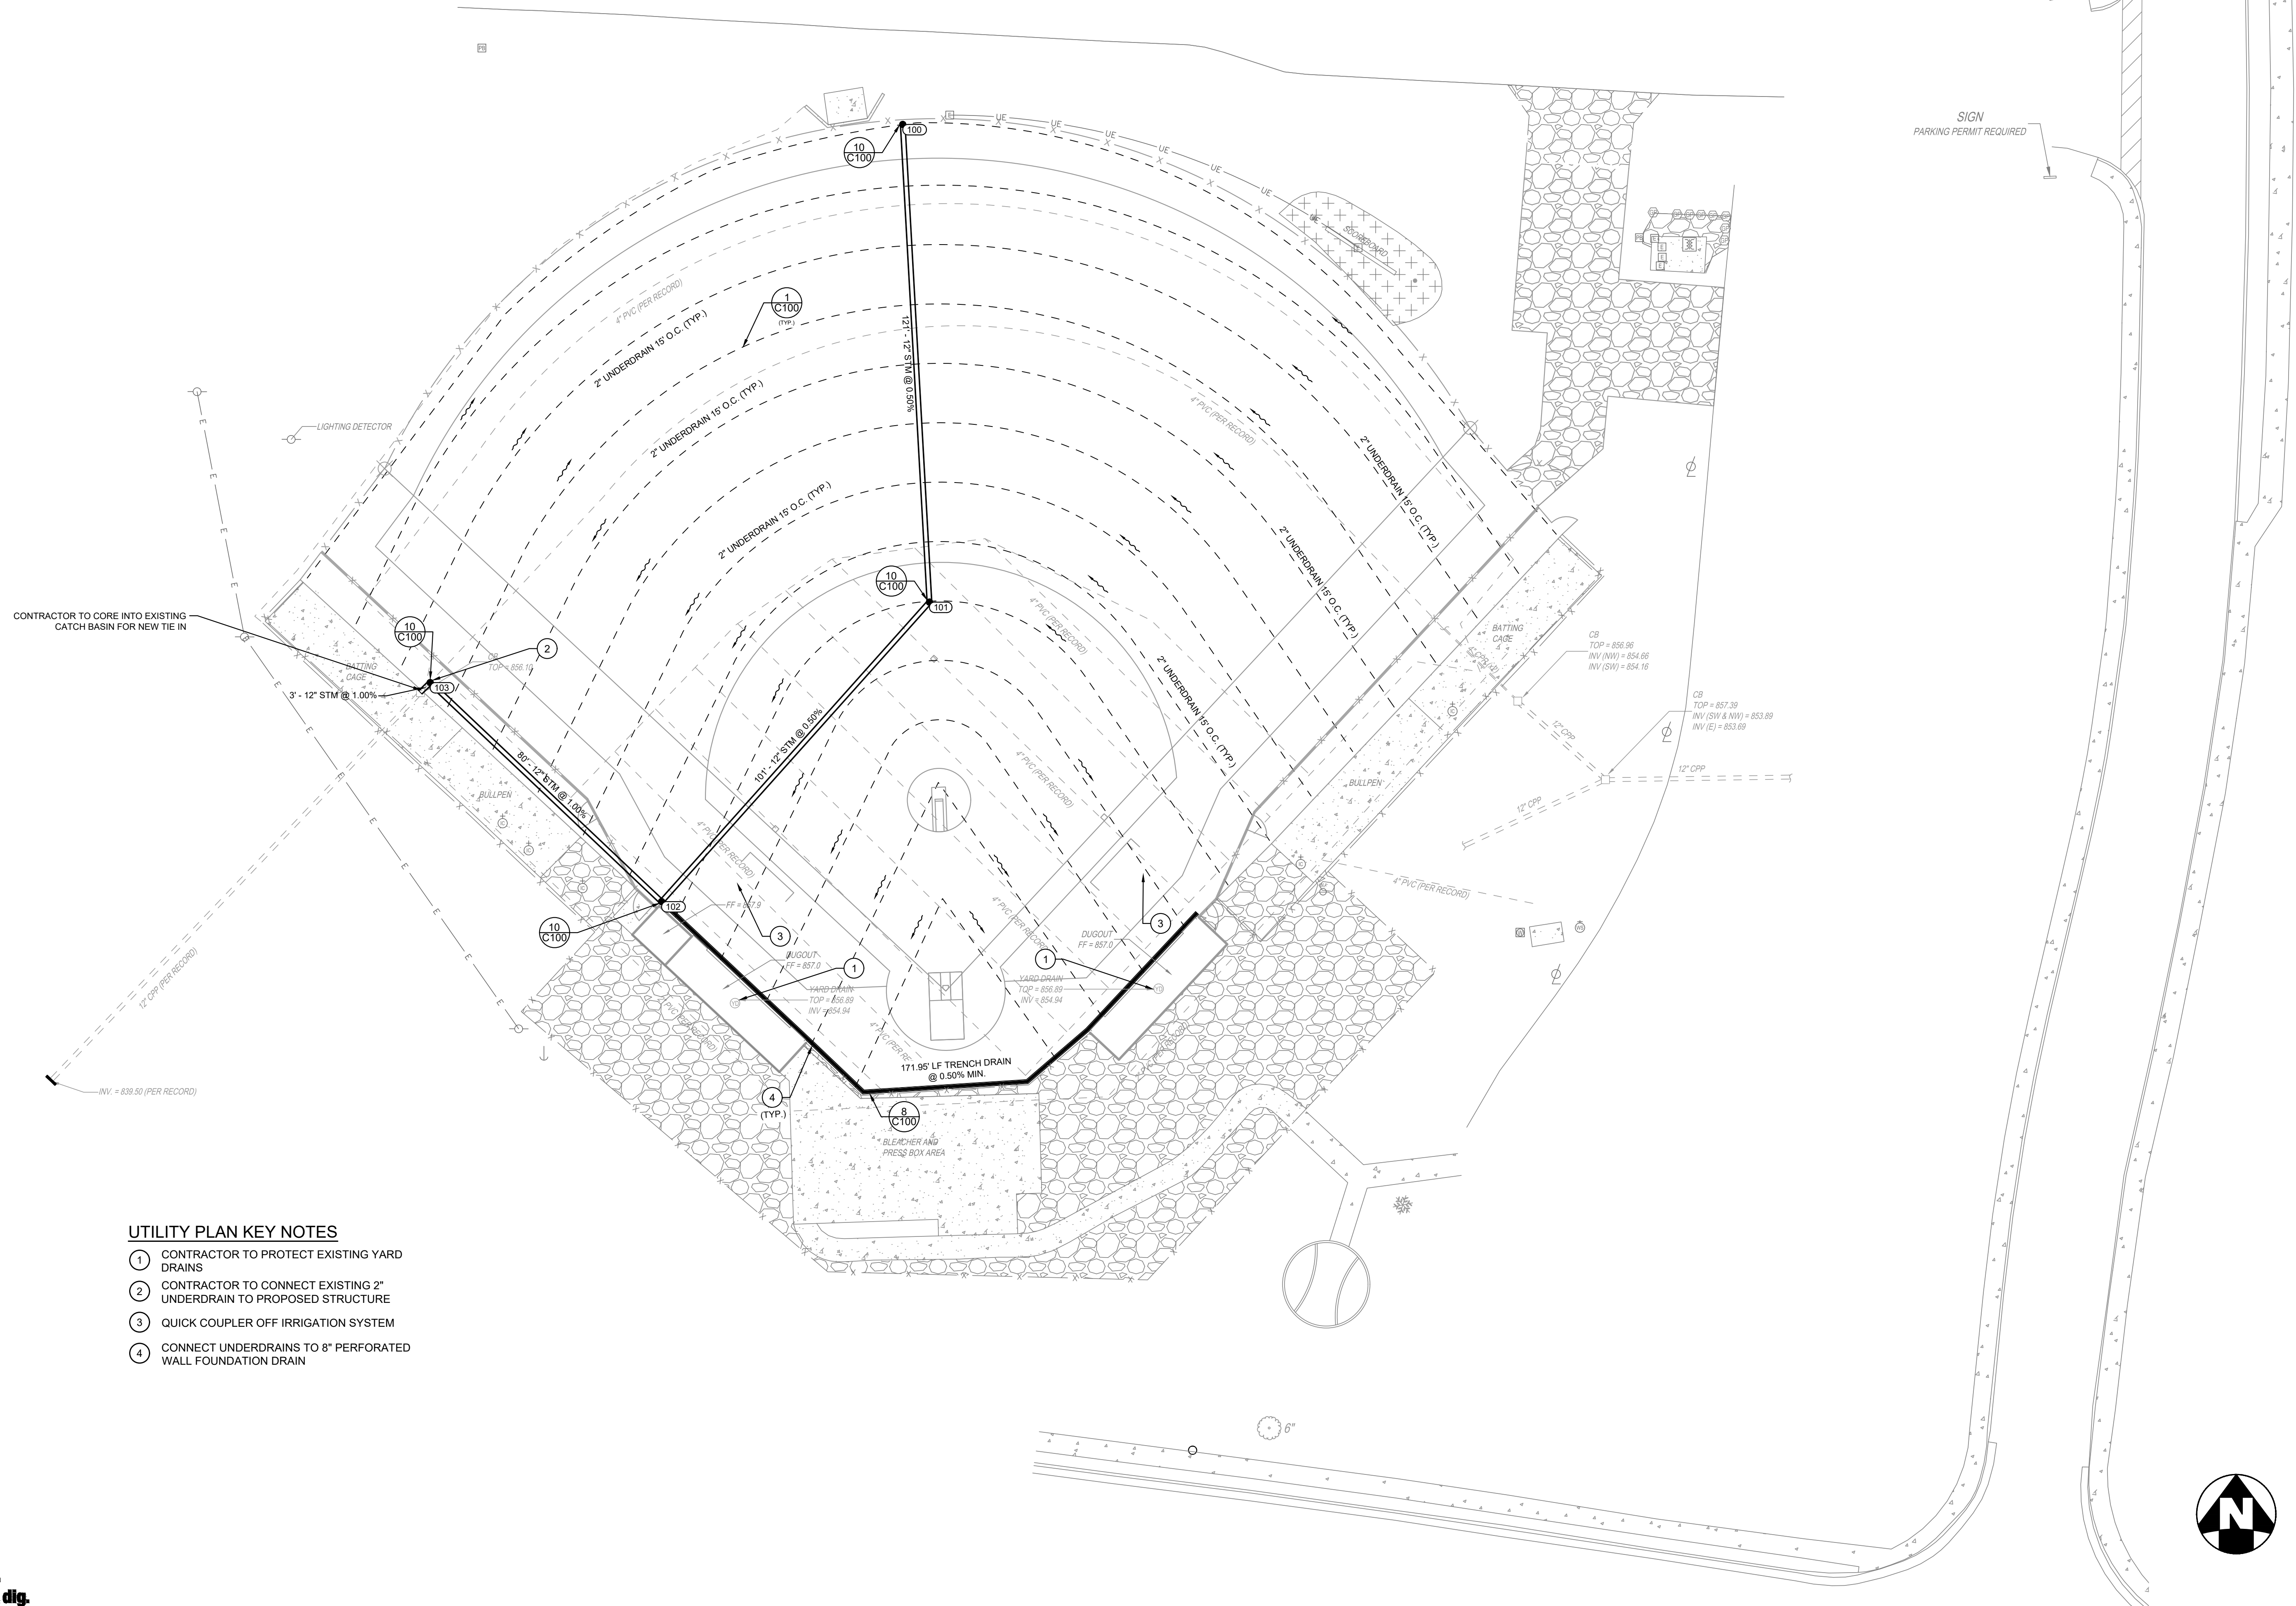


SEAL:

NO.	DATE	DESCRIPTION
1	04/30/2021	FOR BID

**NKU SOFTBALL
FIELD
RENOVATIONS**
CITY OF HIGHLAND HEIGHTS
CAMPBELL COUNTY
COMMONWEALTH OF KENTUCKY

PROJECT NO: 080115.036

DATE: APRIL 2021

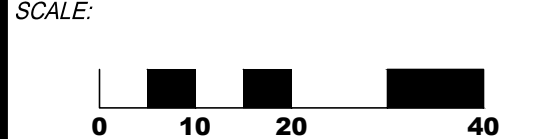

SHEET NAME:

UTILITY PLAN


SHEET NO.

C140



Know what's below.
Call before you dig.

NORTHERN KENTUCKY UNIVERSITY
FRANK IGNATIUS GREIN SOFTBALL
FIELD RENOVATIONS

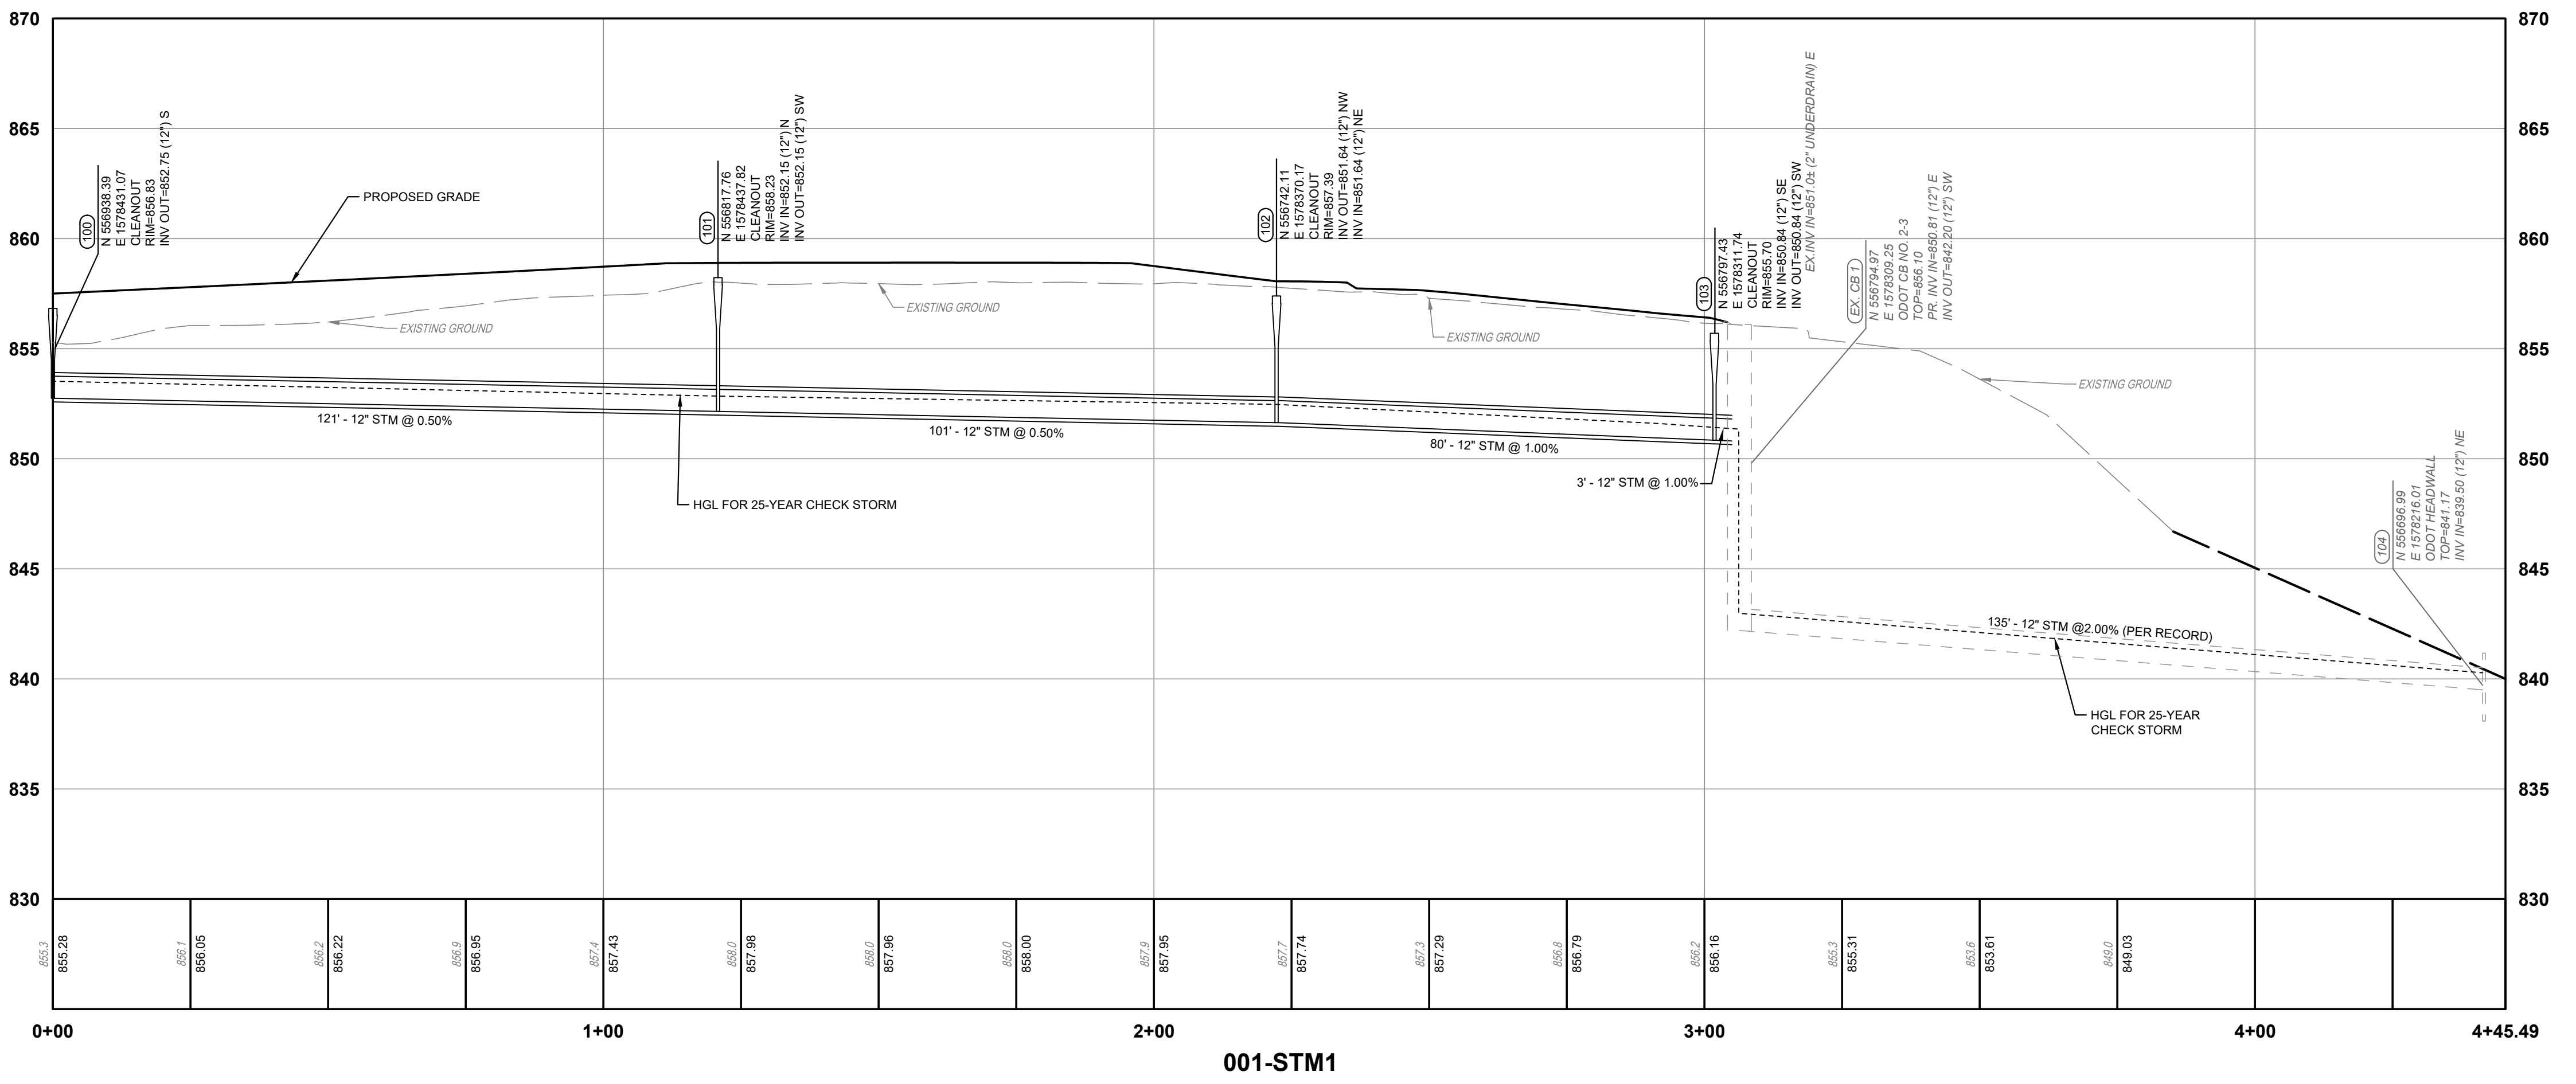


SEAL:

NO.	DATE	DESCRIPTION
1	04/30/2021	FOR BID

NKU SOFTBALL
FIELD
RENOVATIONS
CITY OF HIGHLAND HEIGHTS
CAMPBELL COUNTY
COMMONWEALTH OF KENTUCKY

PROJECT NO: 080115.036

DATE: APRIL 2021

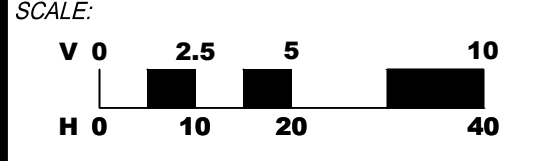

SHEET NAME:

STORM PROFILES

SHEET NO.

C141



Know what's below.
Call before you dig.



**NORTHERN KENTUCKY UNIVERSITY
FRANK IGNATIUS GREIN SOFTBALL
FIELD RENOVATIONS**

SEAL:


NO.	DATE	DESCRIPTION
1	04/30/2021	FOR BID

**NKU SOFTBALL
FIELD
RENOVATIONS**
CITY OF HIGHLAND HEIGHTS
CAMPBELL COUNTY
COMMONWEALTH OF KENTUCKY

PROJECT NO: 080115.036

DATE: APRIL 2021

SCALE:

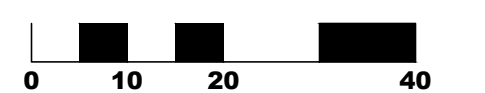

SHEET NAME:

IRRIGATION PLAN

SHEET NO.


C142

IRRIGATION KEY NOTES:

- A. INSTALL SMART IRRIGATION CONTROL (RAINBIRD ST8-2.0, OR EQUAL) IN EXISTING 3RD BASE DUGOUT STORAGE ROOM.
- B. POINT OF CONNECTION.
- C. INSTALL RAIN SENSOR NEAR ROOF OF DUGOUT.
- D. AREA TO BE IRRIGATED.

GENERAL IRRIGATION NOTES

1. CONTRACTOR IS TO TEST IRRIGATION SYSTEM FOR LEAKS AFTER EXISTING FIELD IRRIGATION HAS BEEN REMOVED AND PRIOR TO NEW IRRIGATION SYSTEM BEING INSTALLED.
2. THIS IRRIGATION ZONE PLAN IS DIAGRAMMATIC AND ONLY SHOWS AREAS TO BE IRRIGATED. CONTRACTOR TO DESIGN SYSTEM TO ENSURE FULL AND EQUAL IRRIGATION COVERAGE ON AREAS SHOWN TO BE IRRIGATED.
3. IRRIGATION CONTRACTOR TO COORDINATE THE SIZE OF THE TAP AND THE LOCATION OF THE POINT OF CONNECTION PRIOR TO CONSTRUCTION.
4. THE IRRIGATION SYSTEM SHALL BE INSTALLED USING ACCEPTED AND QUALITY INSTALLATION STANDARDS AS USED IN THE INDUSTRY.
5. IT IS THE RESPONSIBILITY OF THE IRRIGATION CONTRACTOR TO BE FAMILIAR WITH ALL GRADE DIFFERENCES, LOCATIONS OF WALLS, STRUCTURES, AND UTILITIES AND MAKE THE NECESSARY ADJUSTMENTS TO ACCOMMODATE THE IRRIGATION SYSTEM. ANY OBSTRUCTIONS SHOULD BE BROUGHT TO THE ATTENTION OF THE OWNER'S REPRESENTATIVE. IN THE EVENT THAT THIS NOTIFICATION IS NOT PERFORMED, THE IRRIGATION CONTRACTOR SHALL ASSUME FULL RESPONSIBILITY FOR ANY NECESSARY COSTS.
6. MAINLINE PIPING SHALL BE BURIED A MINIMUM OF 12" OF COVER AND A MAXIMUM OF 18" OF COVER. LATERAL LINE PIPING A MINIMUM OF 12" COVER. ALL BACKFILL SURROUNDING THE PIPE SHALL BE SCREENED AND CLEANED OF MATERIAL LARGER THAN 1" IN SIZE.
7. IRRIGATION CONTRACTOR SHALL PROVIDE FIRST WINTERIZATION AND SPRING TURN ON IN BID.
8. THE GENERAL CONTRACTOR IS RESPONSIBLE TO PROVIDE POWER TO THE IRRIGATION, CONTROLLER, SET METER, ALL SLEEVES, TAP, BACKFLOW PREVENTION DEVICE AND TO GAIN ANY AND ALL PERMITTING. IRRIGATION CONTRACTOR TO COORDINATE ALL WORK WITH THE GENERAL CONTRACTOR.
9. WATER FROM IRRIGATION SHALL NOT ENCROACH ON PAVEMENTS.

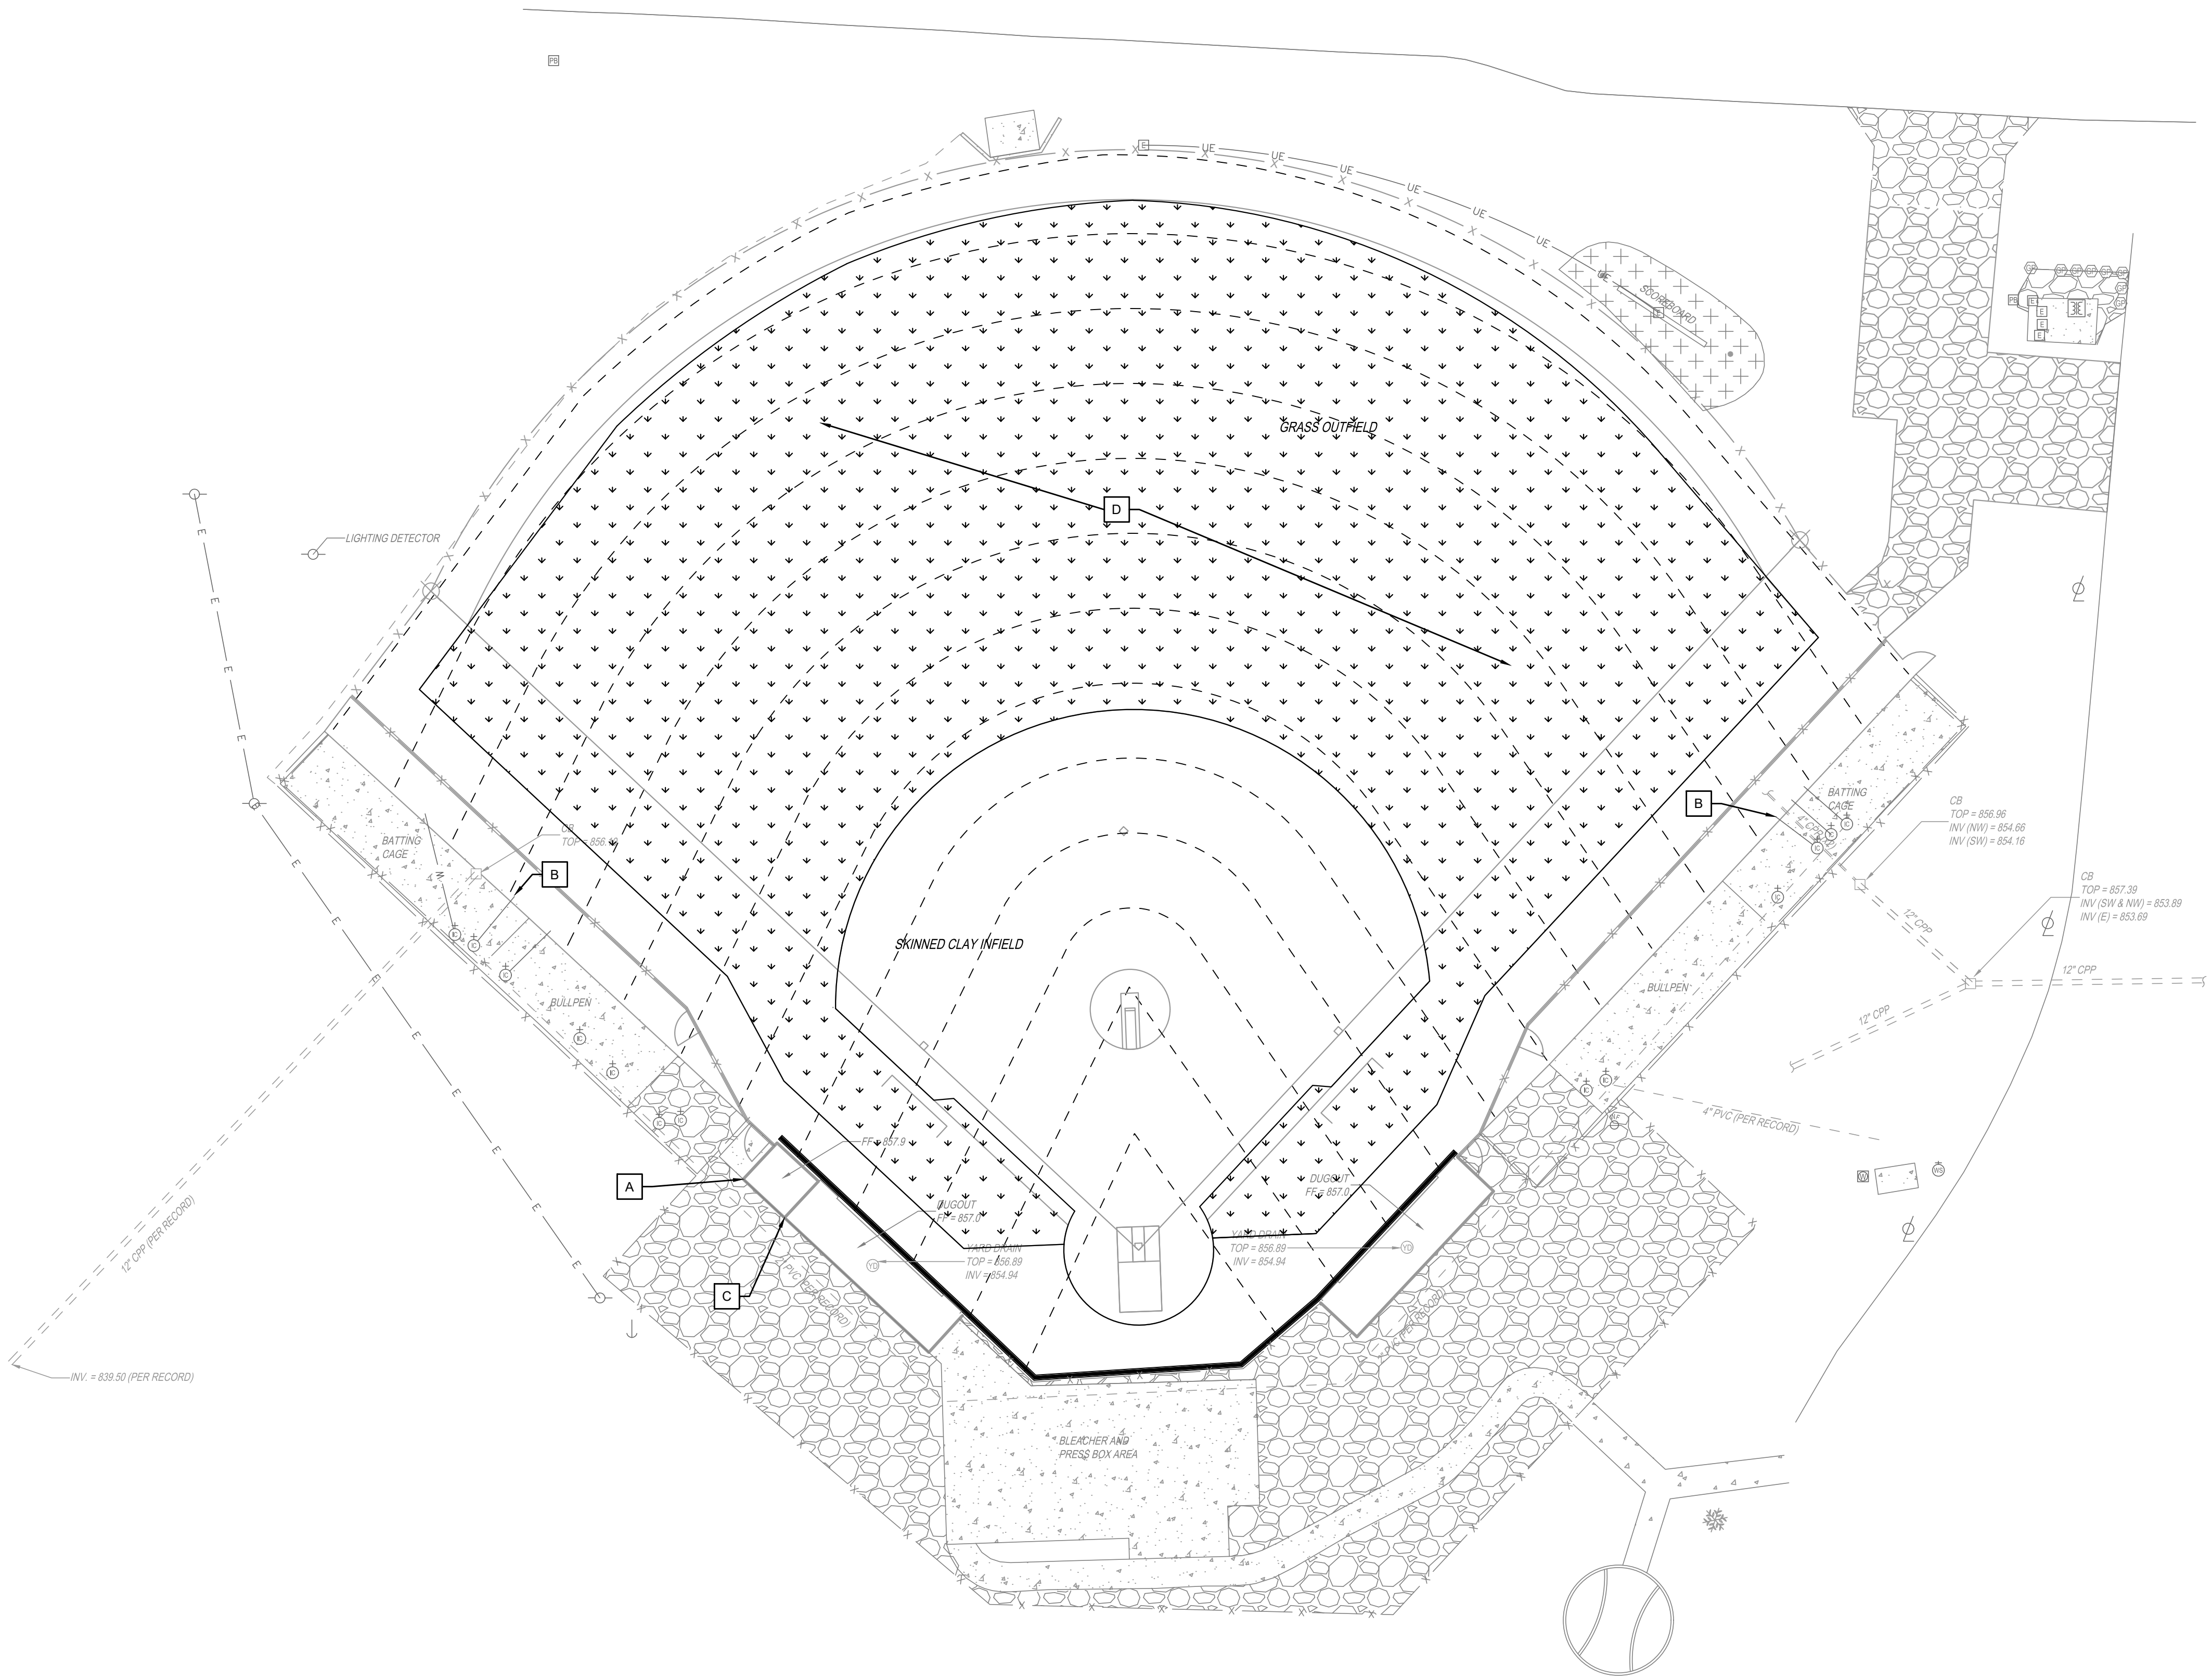

NOTES


- AREA TO BE IRRIGATED



Know what's below.
Call before you dig.

IRON PIN
N: 556603.55
E: 1578504.27

JOHNS HILL ROAD

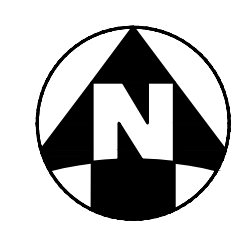


**NORTHERN KENTUCKY UNIVERSITY
FRANK IGNATIUS GREIN SOFTBALL
FIELD RENOVATIONS**

SEAL:

NO.	DATE	DESCRIPTION
1	04/30/2021	FOR BID

**NKU SOFTBALL
FIELD
RENOVATIONS**
CITY OF HIGHLAND HEIGHTS
CAMPBELL COUNTY
COMMONWEALTH OF KENTUCKY

PROJECT NO: 080115.036
DATE: APRIL 2021

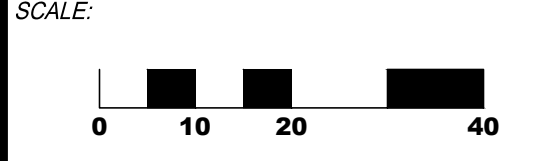


SHEET NAME:

GRADING PLAN

SHEET NO.

C150

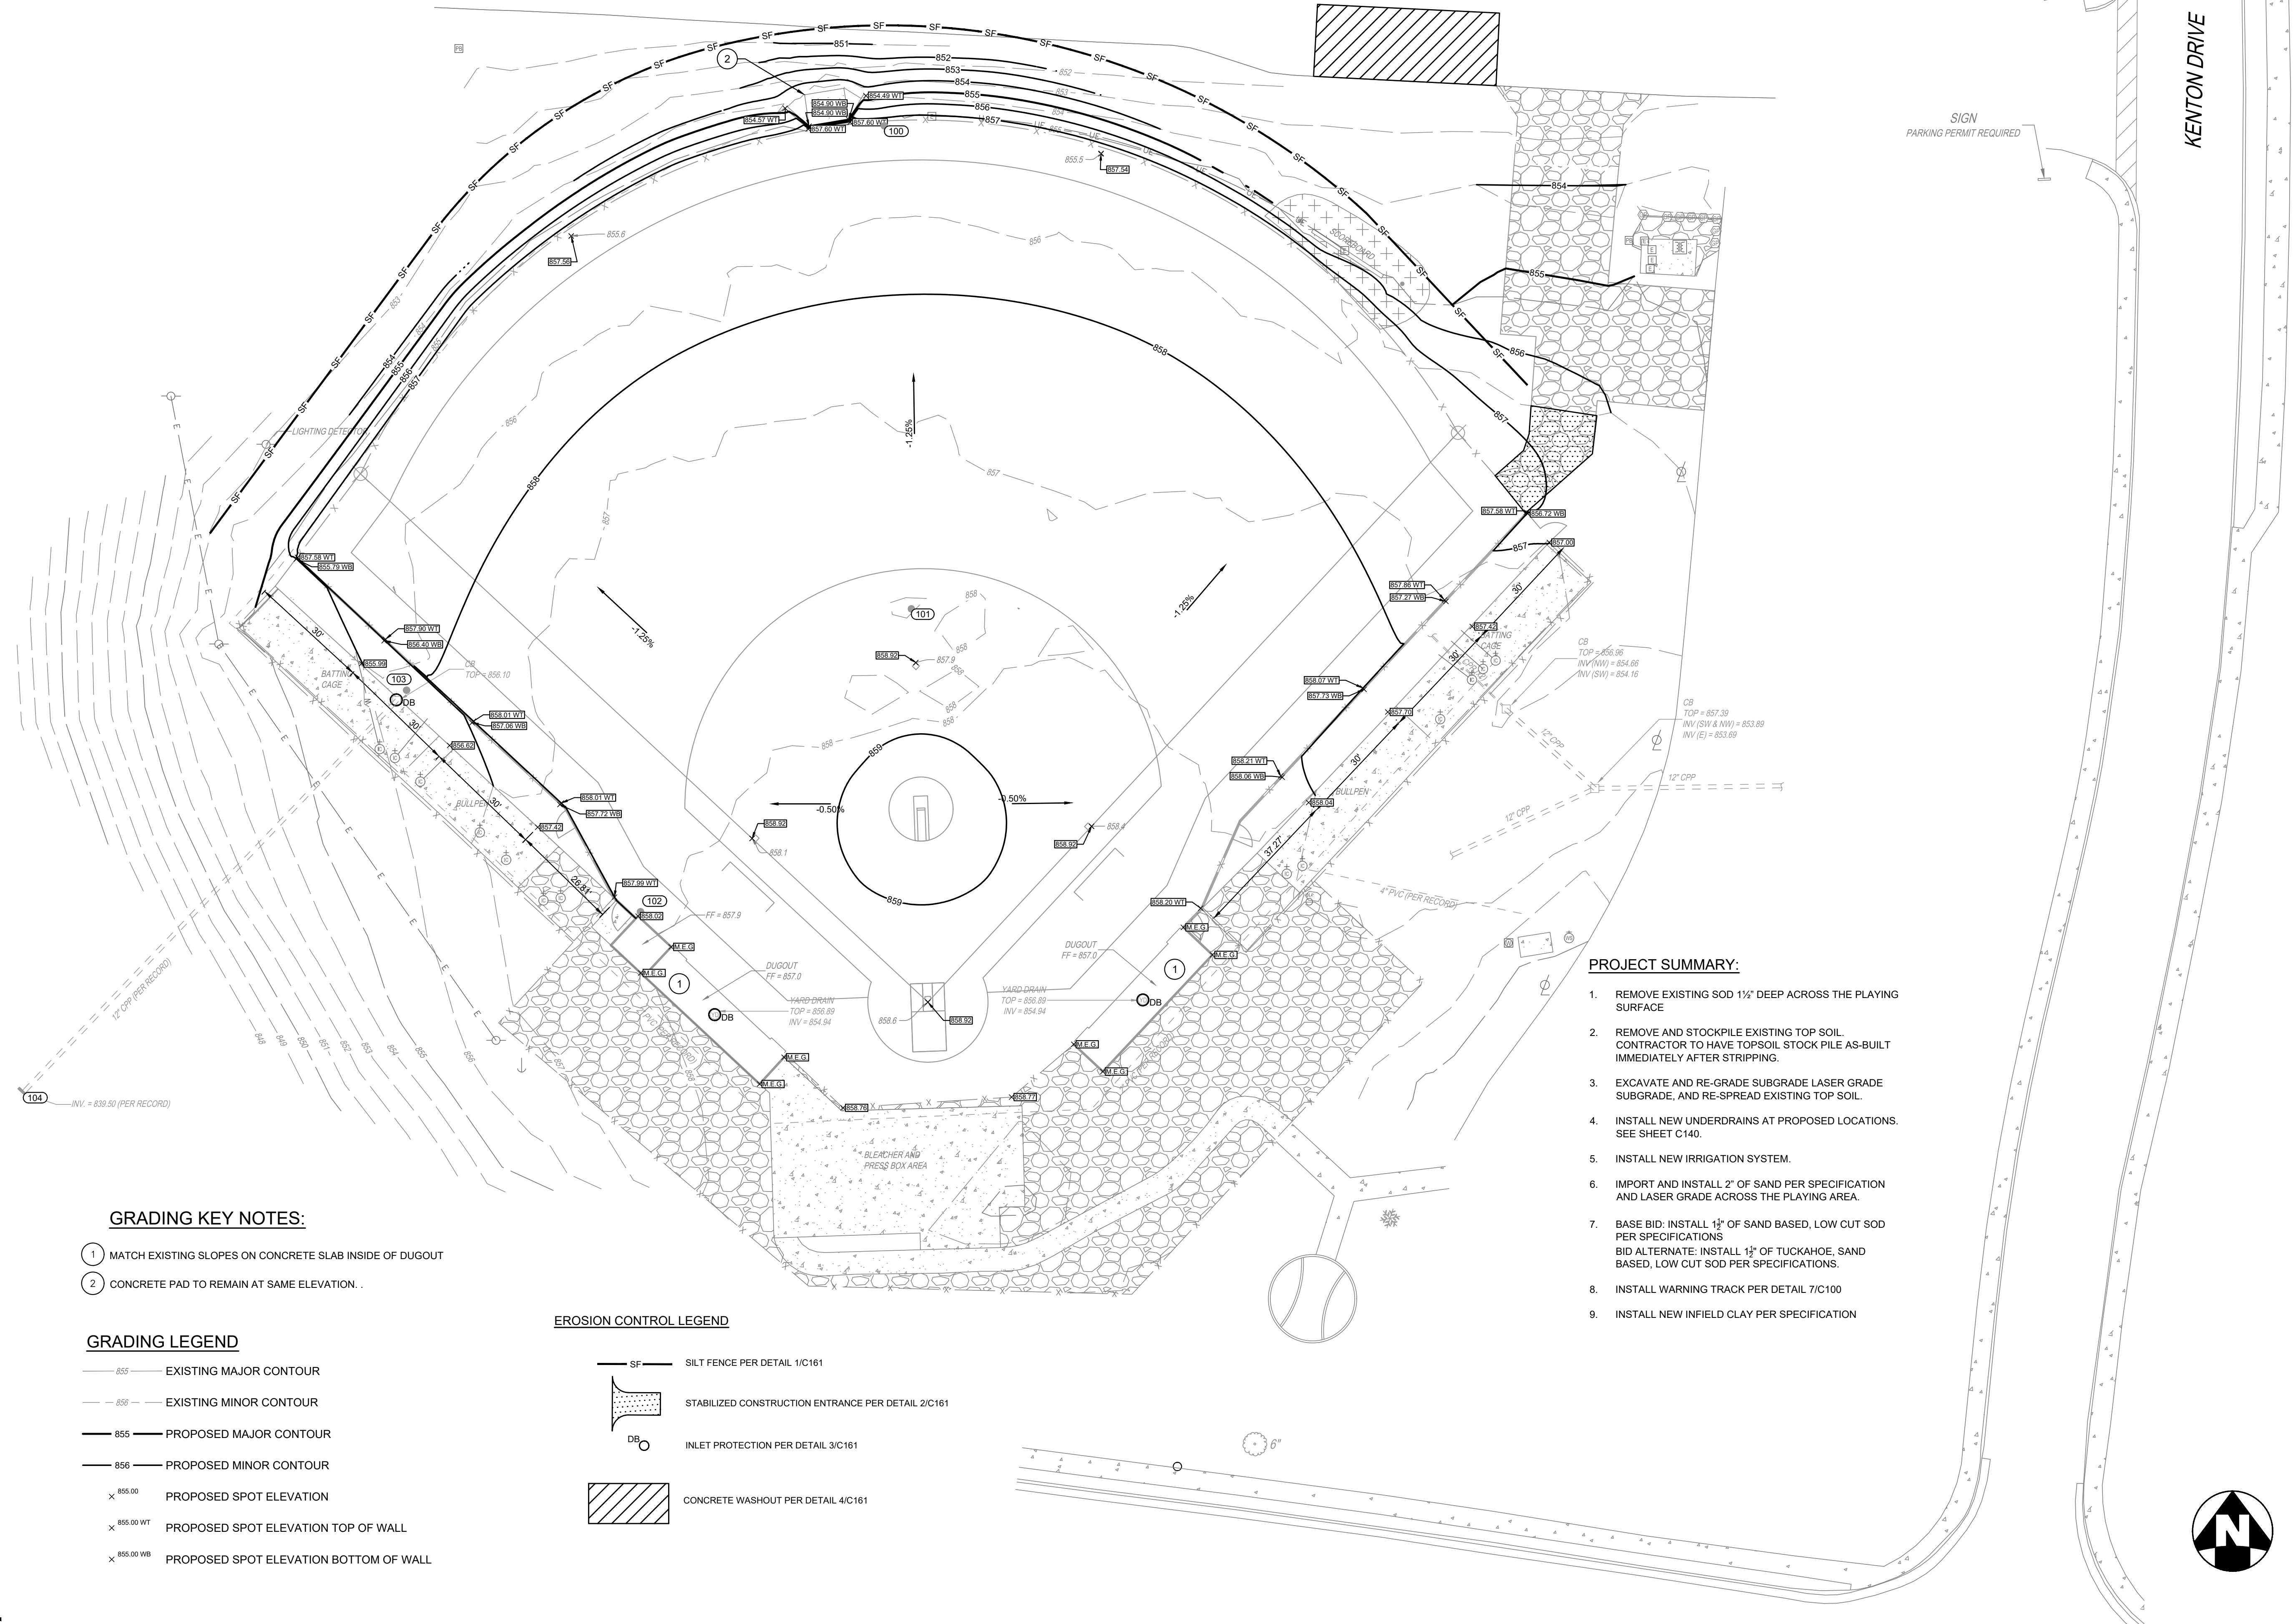


- GRADING KEY NOTES:**
- 1 MATCH EXISTING SLOPES ON CONCRETE SLAB INSIDE OF DUGOUT
 - 2 CONCRETE PAD TO REMAIN AT SAME ELEVATION .


- GRADING LEGEND**
- 855 --- EXISTING MAJOR CONTOUR
 - 856 --- EXISTING MINOR CONTOUR
 - 855 — PROPOSED MAJOR CONTOUR
 - 856 — PROPOSED MINOR CONTOUR
 - x 855.00 PROPOSED SPOT ELEVATION
 - x 855.00 WT PROPOSED SPOT ELEVATION TOP OF WALL
 - x 855.00 WB PROPOSED SPOT ELEVATION BOTTOM OF WALL

- EROSION CONTROL LEGEND**
- SF — SILT FENCE PER DETAIL 1/C161
 - [Symbol] STABILIZED CONSTRUCTION ENTRANCE PER DETAIL 2/C161
 - DB — INLET PROTECTION PER DETAIL 3/C161
 - [Symbol] CONCRETE WASHOUT PER DETAIL 4/C161

PROJECT SUMMARY:

1. REMOVE EXISTING SOD 1 1/2" DEEP ACROSS THE PLAYING SURFACE
2. REMOVE AND STOCKPILE EXISTING TOP SOIL. CONTRACTOR TO HAVE TOPSOIL STOCK PILE AS-BUILT IMMEDIATELY AFTER STRIPPING.
3. EXCAVATE AND RE-GRADE SUBGRADE LASER GRADE SUBGRADE, AND RE-SPREAD EXISTING TOP SOIL.
4. INSTALL NEW UNDERDRAINS AT PROPOSED LOCATIONS. SEE SHEET C140.
5. INSTALL NEW IRRIGATION SYSTEM.
6. IMPORT AND INSTALL 2" OF SAND PER SPECIFICATION AND LASER GRADE ACROSS THE PLAYING AREA.
7. BASE BID: INSTALL 1/2" OF SAND BASED, LOW CUT SOD PER SPECIFICATIONS
BID ALTERNATE: INSTALL 1/2" OF TUCKAHOE, SAND BASED, LOW CUT SOD PER SPECIFICATIONS.
8. INSTALL WARNING TRACK PER DETAIL 7/C100
9. INSTALL NEW INFIELD CLAY PER SPECIFICATION

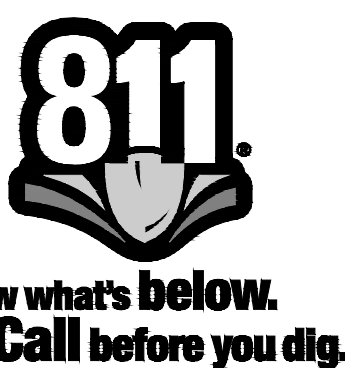

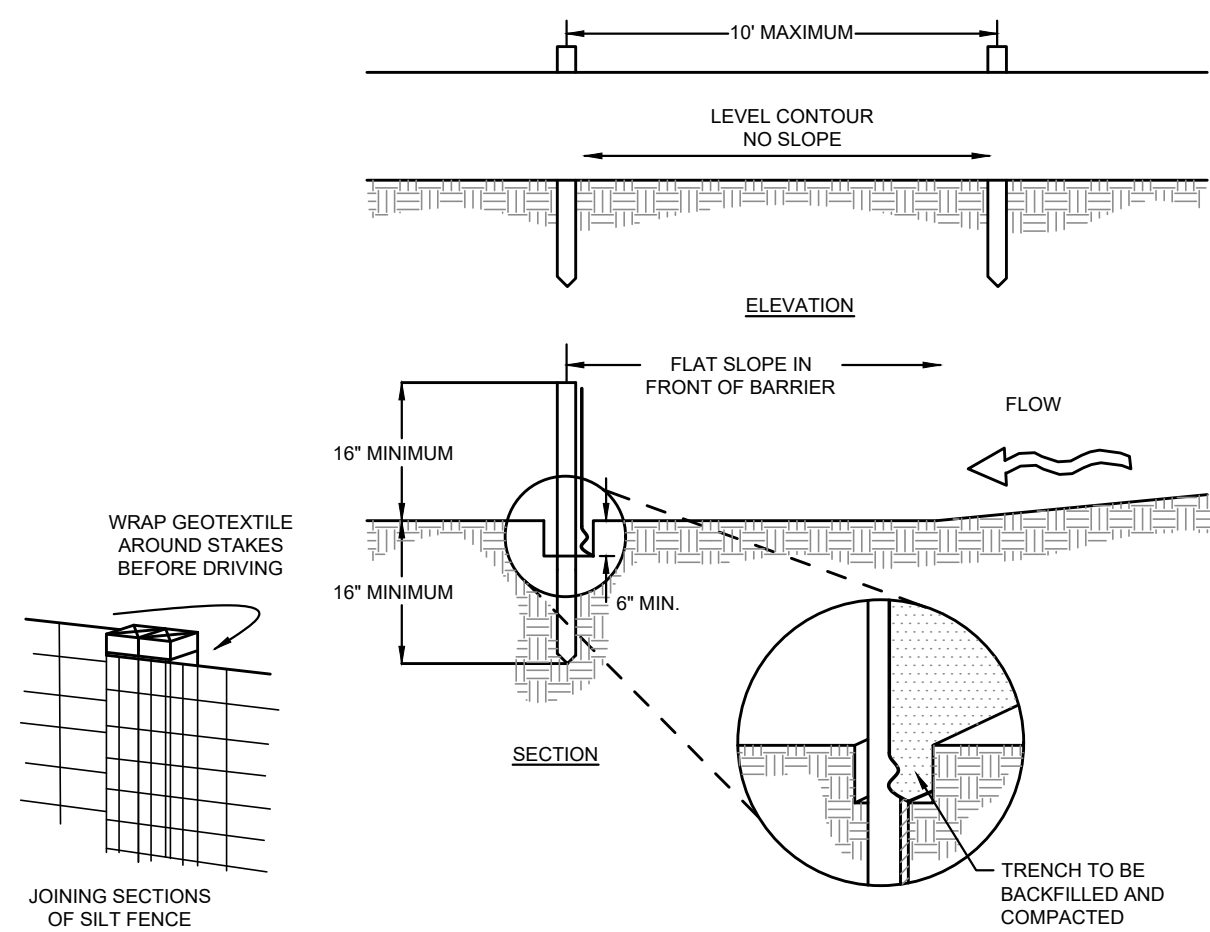

- NOTES:
- SILT FENCE SHALL BE CONSTRUCTED BEFORE UPSLOPE LAND DISTURBANCE BEGINS.
 - ALL SILT FENCE SHALL BE PLACED AS CLOSE TO THE CONTOUR AS POSSIBLE SO THAT WATER WILL NOT CONCENTRATE AT LOW POINTS IN THE FENCE AND SO THAT SMALL SWALES OR DEPRESSIONS THAT MAY CARRY SMALL CONCENTRATED FLOWS TO THE SILT FENCE ARE DISSIPATED ALONG ITS LENGTH.
 - ENDS OF THE SILT FENCES SHALL BE BROUGHT UPSLOPE SLIGHTLY SO THAT WATER PONDED BY THE SILT FENCE WILL BE PREVENTED FROM FLOWING AROUND THE ENDS.
 - SILT FENCE SHALL BE PLACED ON THE FLATTEST AREA AVAILABLE.
 - WHERE POSSIBLE, VEGETATION SHALL BE PRESERVED FOR 5 FEET (OR AS MUCH AS POSSIBLE) UPSLOPE FROM THE SILT FENCE. IF VEGETATION IS REMOVED, IT SHALL BE REESTABLISHED WITHIN 7 DAYS FROM THE INSTALLATION OF THE SILT FENCE.
 - THE HEIGHT OF THE SILT FENCE SHALL BE A MINIMUM OF 16 INCHES ABOVE THE ORIGINAL GROUND SURFACE.
 - THE SILT FENCE SHALL BE PLACED IN AN EXCAVATED OR SLICED TRENCH CUT A MINIMUM OF 6 INCHES DEEP. THE TRENCH SHALL BE MADE WITH A TRENCHER, CABLE LAYING MACHINE, SLICING MACHINE, OR OTHER SUITABLE DEVICE THAT WILL ENSURE AN ADEQUATELY UNIFORM TRENCH DEPTH.
 - THE SILT FENCE SHALL BE PLACED WITH THE STAKES ON THE DOWNSLOPE SIDE OF THE GEOTEXTILE. A MINIMUM OF 8 INCHES OF GEOTEXTILE MUST BE BELOW THE GROUND SURFACE. EXCESS MATERIAL SHALL LAY ON THE BOTTOM OF THE 6-INCH DEEP TRENCH. THE TRENCH SHALL BE BACKFILLED AND COMPACTED ON BOTH SIDES OF THE FABRIC.
 - SEAMS BETWEEN SECTIONS OF SILT FENCE SHALL BE SPICED TOGETHER ONLY AT A SUPPORT POST WITH A MINIMUM 6-IN. OVERLAP PRIOR TO DRIVING INTO THE GROUND.
 - MAINTENANCE—SILT FENCE SHALL ALLOW RUNOFF TO PASS ONLY AS DIFFUSE FLOW THROUGH THE GEOTEXTILE. IF RUNOFF OVERTOPS THE

SILT FENCE, FLOWS UNDER THE FABRIC OR AROUND THE FENCE ENDS, OR IN ANY OTHER WAY ALLOWS A CONCENTRATED FLOW DISCHARGE. ONE OF THE FOLLOWING SHALL BE PERFORMED, AS APPROPRIATE: 1) THE LAYOUT OF THE SILT FENCE SHALL BE CHANGED, 2) ACCUMULATED SEDIMENT SHALL BE REMOVED, OR 3) OTHER PRACTICES SHALL BE INSTALLED.

SEDIMENT DEPOSITS SHALL BE ROUTINELY REMOVED WHEN THE HEIGHT OF THE SILT FENCE APPROXIMATELY ONE-HALF OF THE HEIGHT OF THE SILT FENCE.


SILT FENCES SHALL BE INSPECTED AFTER EACH RAINFALL AND AT LEAST DAILY DURING A PROLONGED RAINFALL. THE LOCATION OF EXISTING SILT FENCE SHALL BE REVIEWED DAILY TO ENSURE ITS PROPER LOCATION AND EFFECTIVENESS. IF DAMAGED, THE SILT FENCE SHALL BE REPAIRED IMMEDIATELY.

CRITERIA FOR SILT FENCE MATERIALS

- FENCE POST - THE LENGTH SHALL BE A MINIMUM OF 32 INCHES. WOOD POSTS WILL BE 2-8Y-2-IN. NOMINAL DIMENSIONED HARDWOOD OF SOUND QUALITY. THEY SHALL BE FREE OF KNOTS, SPLITS AND OTHER VISIBLE IMPERFECTIONS, THAT WILL WEAKEN THE POSTS. THE MAXIMUM SPACING BETWEEN POSTS SHALL BE 10 FT. POSTS SHALL BE DRIVEN A MINIMUM 16 INCHES INTO THE GROUND, WHERE POSSIBLE. IF NOT POSSIBLE, THE POSTS SHALL BE ADEQUATELY SECURED TO PREVENT OVERTURNING OF THE FENCE DUE TO SEDIMENT/WATER LOADINGS.
- SILT FENCE FABRIC - SEE CHART BELOW.

FABRIC PROPERTIES	VALUES	TEST METHOD
MINIMUM TENSILE STRENGTH	120 LBS (50% N)	ASTM D 4632
MAXIMUM ELONGATION AT 60 LBS	50%	ASTM D 4632
MINIMUM PUNCTURE STRENGTH	50 LBS (220 N)	ASTM D 4833
MINIMUM TEAR STRENGTH	40 LBS (180 N)	ASTM D 4533
APPARENT OPENING SIZE	<0.84 MM	ASTM D 4751
MINIMUM PERMITTIVITY	1X10 ⁻² SEC ⁻¹	ASTM D 4491
UV EXPOSURE STRENGTH RETENTION	70%	ASTM G 4565

1 C161 SILT FENCE DETAIL N.T.S.

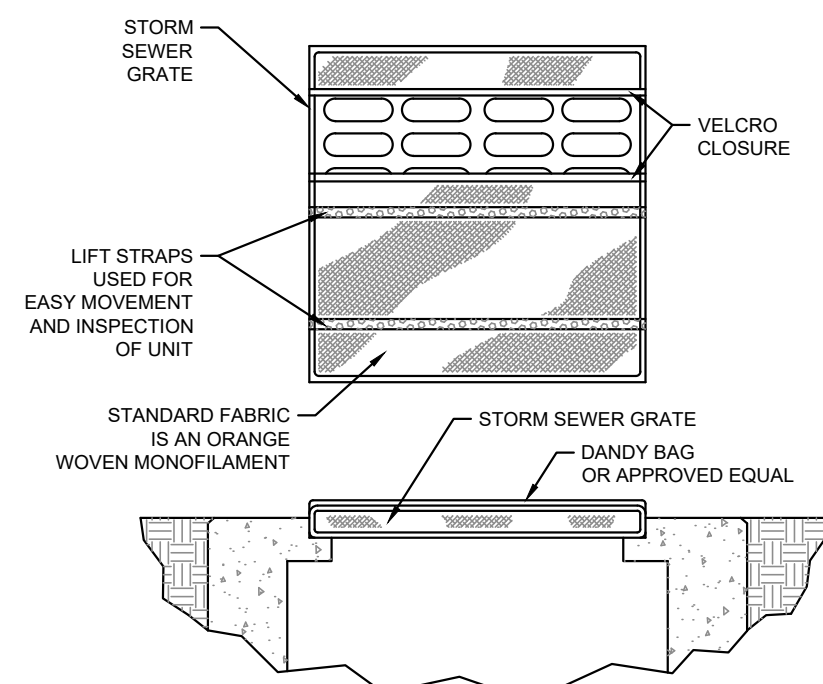


SPECIFICATIONS

MECHANICAL PROPERTIES	TEST METHOD	UNITS	MARV
GRAB TENSILE STRENGTH	ASTM D 4832	KN (LBS)	1.62 (365) X 0.89 (200)
GRAB TENSILE ELONGATION	ASTM D 4832	%	2 X 10
PUNCTURE STRENGTH	ASTM D 4833	KN (LBS)	0.40 (90)
MULLEN BURST STRENGTH	ASTM D 3786	KPA (PSI)	3097 (450)
TRAPEZOID TEAR STRENGTH	ASTM D 4533	KN (LBS)	0.51 (115) X 0.33 (75)
UV RESISTANCE	ASTM D 4355	%	90
APPARENT OPENING SIZE	ASTM D 4751	MM (US STD SIEVE)	0.425 (40)
FLOW RATE	ASTM D 4491	1MINUM (GAL/MIN/FT ²)	5907 (145)
PERMITTIVITY	ASTM D 4491	SEC	2.1

INSTALLATION: THE EMPTY DANDY BAG SHOULD BE PLACED OVER THE GRATE AS THE GRATE STANDS ON END. IF USING OPTIONAL OIL ABSORBENTS, PLACE ABSORBENT PILLOW IN POUCH, ON THE BOTTOM (BELOW-GRADE SIDE) OF THE UNIT. ATTACH ABSORBENT PILLOW TO TETHER LOOP. TUCK THE ENCLOSURE FLAP INSIDE TO COMPLETELY ENCLOSE THE GRATE. HOLDING THE LIFTING DEVICES (DO NOT RELY ON LIFTING DEVICES TO SUPPORT THE ENTIRE WEIGHT OF THE GRATE), PLACE THE GRATE INTO ITS FRAME.

MAINTENANCE: REMOVE ALL ACCUMULATED SEDIMENT AND DEBRIS FROM SURFACE AND VICINITY OF UNIT AFTER EACH STORM EVENT. REMOVE SEDIMENT THAT HAS ACCUMULATED WITHIN THE CONTAINMENT AREA OF THE DANDY BAG AS NEEDED. IF USING OPTIONAL OIL ABSORBENTS, REMOVE AND REPLACE ABSORBENT PILLOW WHEN NEAR SATURATION.


2 C161 DANDY BAG DETAIL N.T.S.

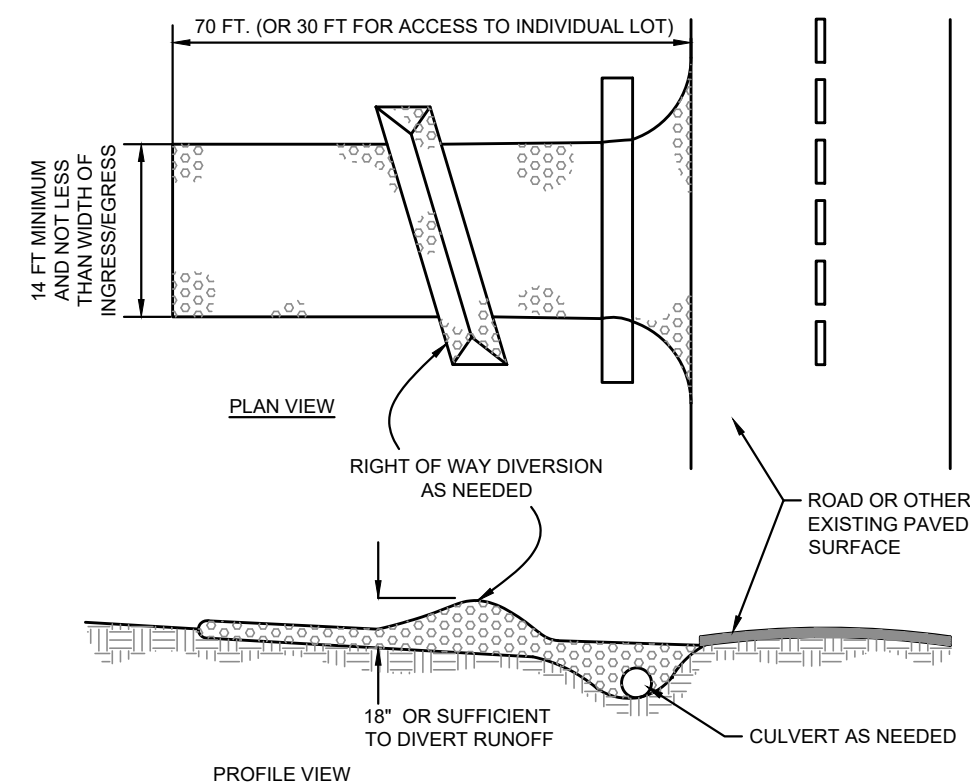

- NOTES:
- STONE SIZE - ODOT #2 (1.5-2.5 INCH) STONE SHALL BE USED, OR RECYCLED CONCRETE EQUIVALENT.
 - LENGTH - THE CONSTRUCTION ENTRANCE SHALL BE AS LONG AS REQUIRED TO STABILIZE HIGH TRAFFIC AREAS BUT NOT LESS THAN 70 FT. (EXCEPTION: APPLY 30 FT. MINIMUM TO SINGLE RESIDENCE LOTS).
 - THICKNESS - THE STONE LAYER SHALL BE AT LEAST 6 INCHES THICK FOR LIGHT DUTY ENTRANCES OR AT LEAST 10 INCHES FOR HEAVY DUTY USE.
 - WIDTH - THE ENTRANCE SHALL BE AT LEAST 14 FEET WIDE, BUT NOT LESS THAN THE FULL WIDTH AT POINTS WHERE INGRESS OR EGRESS OCCURS.
 - GEOTEXTILE - A GEOTEXTILE SHALL BE LAID OVER THE ENTIRE AREA PRIOR TO PLACING STONE. IT SHALL BE COMPOSED OF STRONG ROT-PROOF POLYMERIC FIBERS AND MEET THE FOLLOWING SPECIFICATIONS:

MINIMUM TENSILE STRENGTH	200 LBS
MINIMUM PUNCTURE STRENGTH	80 LBS
MINIMUM TEAR STRENGTH	50 LBS
MINIMUM BURST STRENGTH	320 PSI
MINIMUM ELONGATION	20%
EQUIVALENT OPENING SIZE	EQS+ 0.6MM
PERMITTIVITY	1X10 ⁻² CM/SEC
 - TIMING - THE CONSTRUCTION ENTRANCE SHALL BE INSTALLED AS SOON AS IS PRACTICABLE BEFORE MAJOR GRADING ACTIVITIES.
 - CULVERT - A PIPE OR CULVERT SHALL BE CONSTRUCTED UNDER THE ENTRANCE IF OR NECESSARY TO PREVENT SURFACE WATER FROM FLOWING
- ACROSS THE ENTRANCE OR TO PREVENT RUNOFF FROM BEING DIRECTED OUT ONTO PAVED SURFACES.
- WATER BAR - A WATER BAR SHALL BE CONSTRUCTED AS PART OF THE CONSTRUCTION ENTRANCE IF NEEDED TO PREVENT SURFACE RUNOFF FROM FLOWING THE LENGTH OF THE CONSTRUCTION ENTRANCE AND OUT ONTO PAVED SURFACES.
 - MAINTENANCE - THE ENTRANCE SHALL BE MAINTAINED IN A CONDITION THAT WILL PREVENT TRACKING OR FLOW OF MUD ONTO PUBLIC RIGHTS-OF-WAY. THIS MAY REQUIRE PERIODIC TOP DRESSING WITH ADDITIONAL STONE OR THE WASHING AND REWORKING OF EXISTING STONE AS CONDITIONS DEMAND AND REPAIR AND/OR CLEANOUT OF ANY STRUCTURES USED TO TRAP SEDIMENT. ALL MATERIALS SPILLED, DROPPED, WASHED, OR TRACKED FROM VEHICLES ONTO ROADWAYS OR INTO STORM DRAINS MUST BE REMOVED IMMEDIATELY. THE USE OF WATER TRUCKS TO REMOVE MATERIALS DROPPED, WASHED, OR TRACKED ONTO ROADWAYS WILL NOT BE PERMITTED UNDER ANY CIRCUMSTANCES. TOP DRESSING OF ADDITIONAL STONE SHALL BE APPLIED AS CONDITIONS DEMAND. MUD SPILLED, DROPPED, WASHED OR TRACKED ONTO PUBLIC ROADS, OR ANY SURFACE WHERE RUNOFF IS NOT CHECKED BY SEDIMENT CONTROLS, SHALL BE REMOVED IMMEDIATELY. REMOVAL SHALL BE ACCOMPLISHED BY SCRAPING OR SWEEPING.
 - CONSTRUCTION ENTRANCES SHALL NOT BE RELIED UPON TO REMOVE MUD FROM VEHICLES AND PREVENT OFF-SITE TRACKING. VEHICLES THAT ENTER AND LEAVE THE CONSTRUCTION-SITE SHALL BE RESTRICTED FROM MUDDY AREAS.
 - REMOVAL - THE ENTRANCE SHALL REMAIN IN PLACE UNTIL THE DISTURBED AREA IS STABILIZED OR REPLACED WITH A PERMANENT ROADWAY OR ENTRANCE.

3 C161 CONSTRUCTION ENTRANCE DETAIL N.T.S.

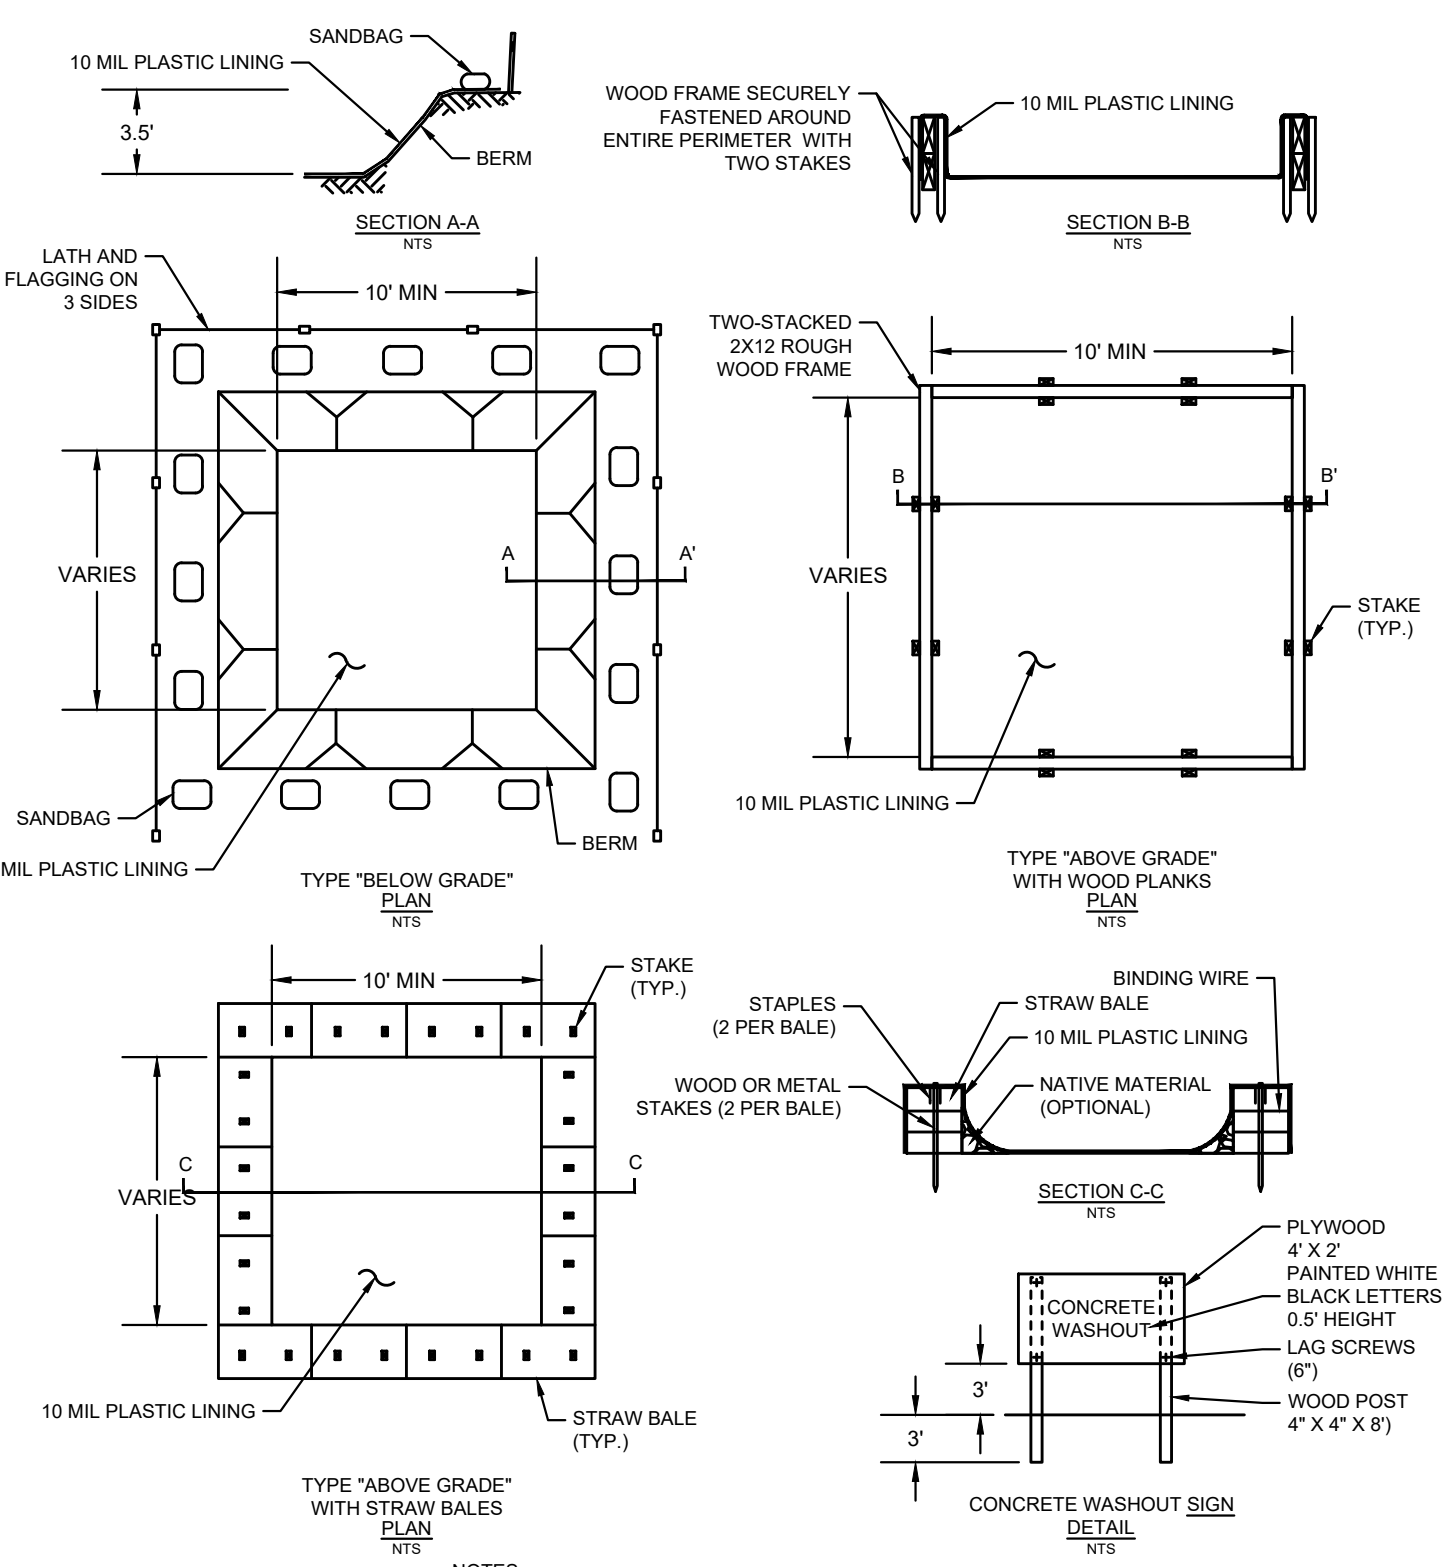

- NOTES:
- ACTUAL LAYOUT DETERMINED IN THE FIELD.
 - THE CONCRETE WASHOUT SIGN SHALL BE INSTALLED WITHIN 30' OF THE TEMPORARY CONCRETE WASHOUT FACILITY.

4 C161 CONCRETE WASHOUT DETAIL N.T.S.



NORTHERN KENTUCKY UNIVERSITY
FRANK IGNATIUS GREIN SOFTBALL
FIELD RENOVATIONS

SEAL:

NO. DATE DESCRIPTION
1 04/30/2021 FOR BID

NKU SOFTBALL FIELD RENOVATIONS
CITY OF HIGHLAND HEIGHTS
CAMPBELL COUNTY
COMMONWEALTH OF KENTUCKY

PROJECT NO: 080115.036

DATE: APRIL 2021

SCALE:

SHEET NAME:
EROSION CONTROL DETAILS

SHEET NO.


C161




Know what's below.
Call before you dig.



**NORTHERN KENTUCKY UNIVERSITY
FRANK IGNATIUS GREIN SOFTBALL
FIELD RENOVATIONS**

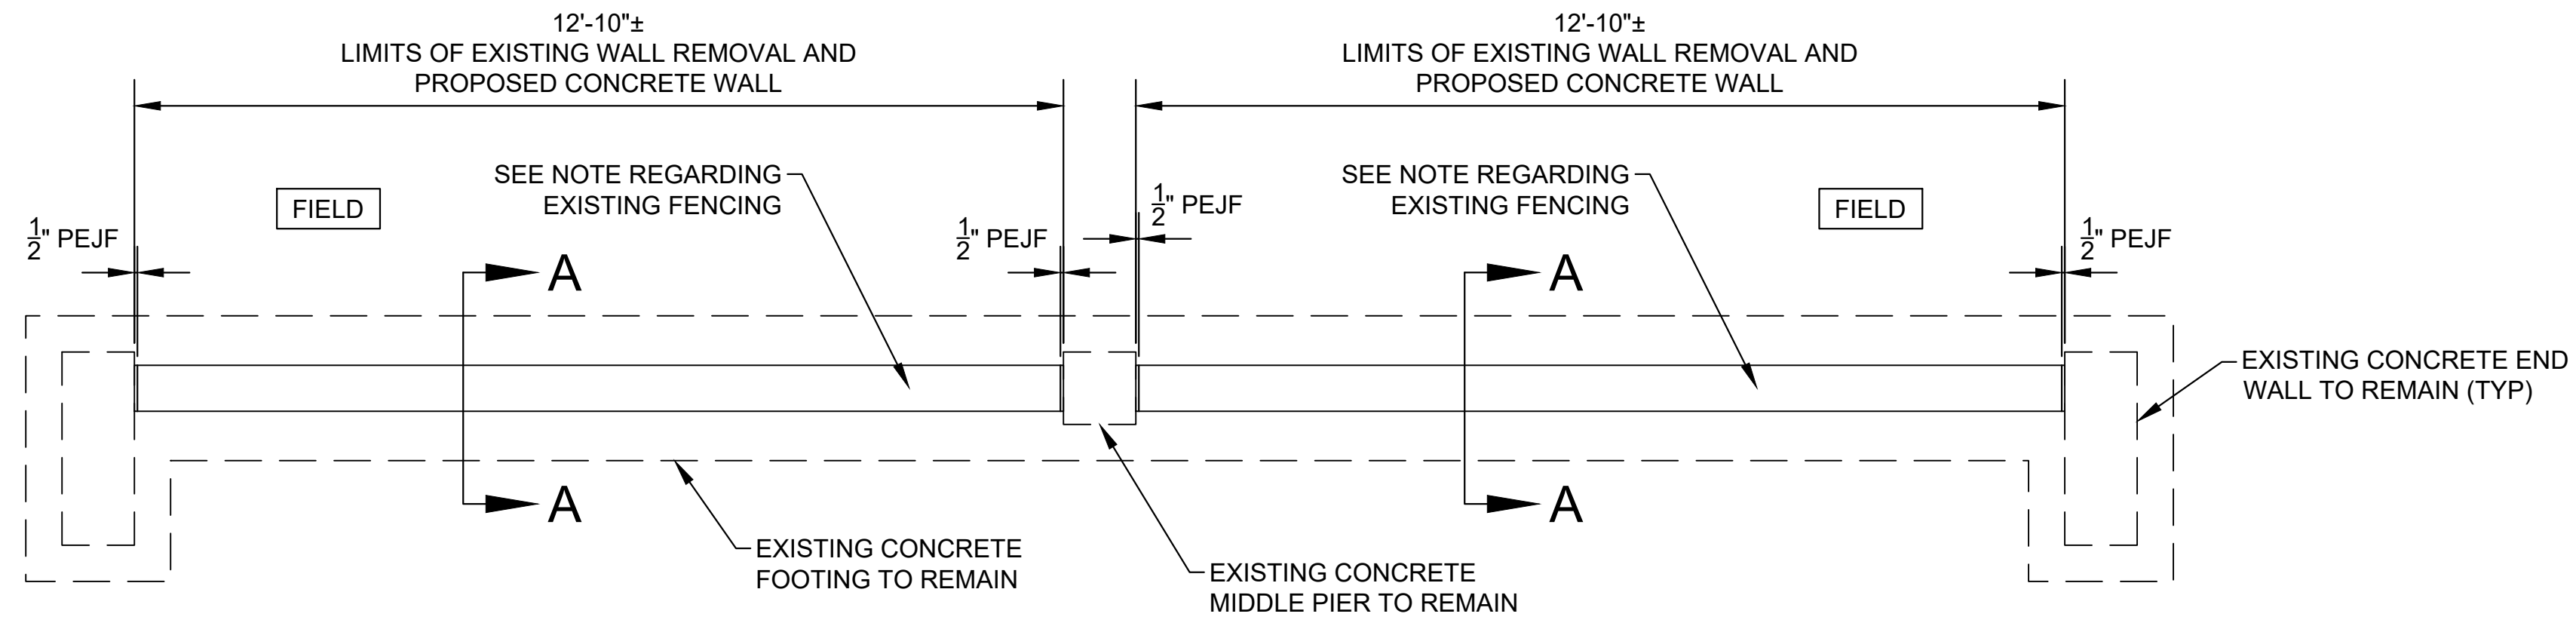

PLAN - TYPICAL DUGOUT

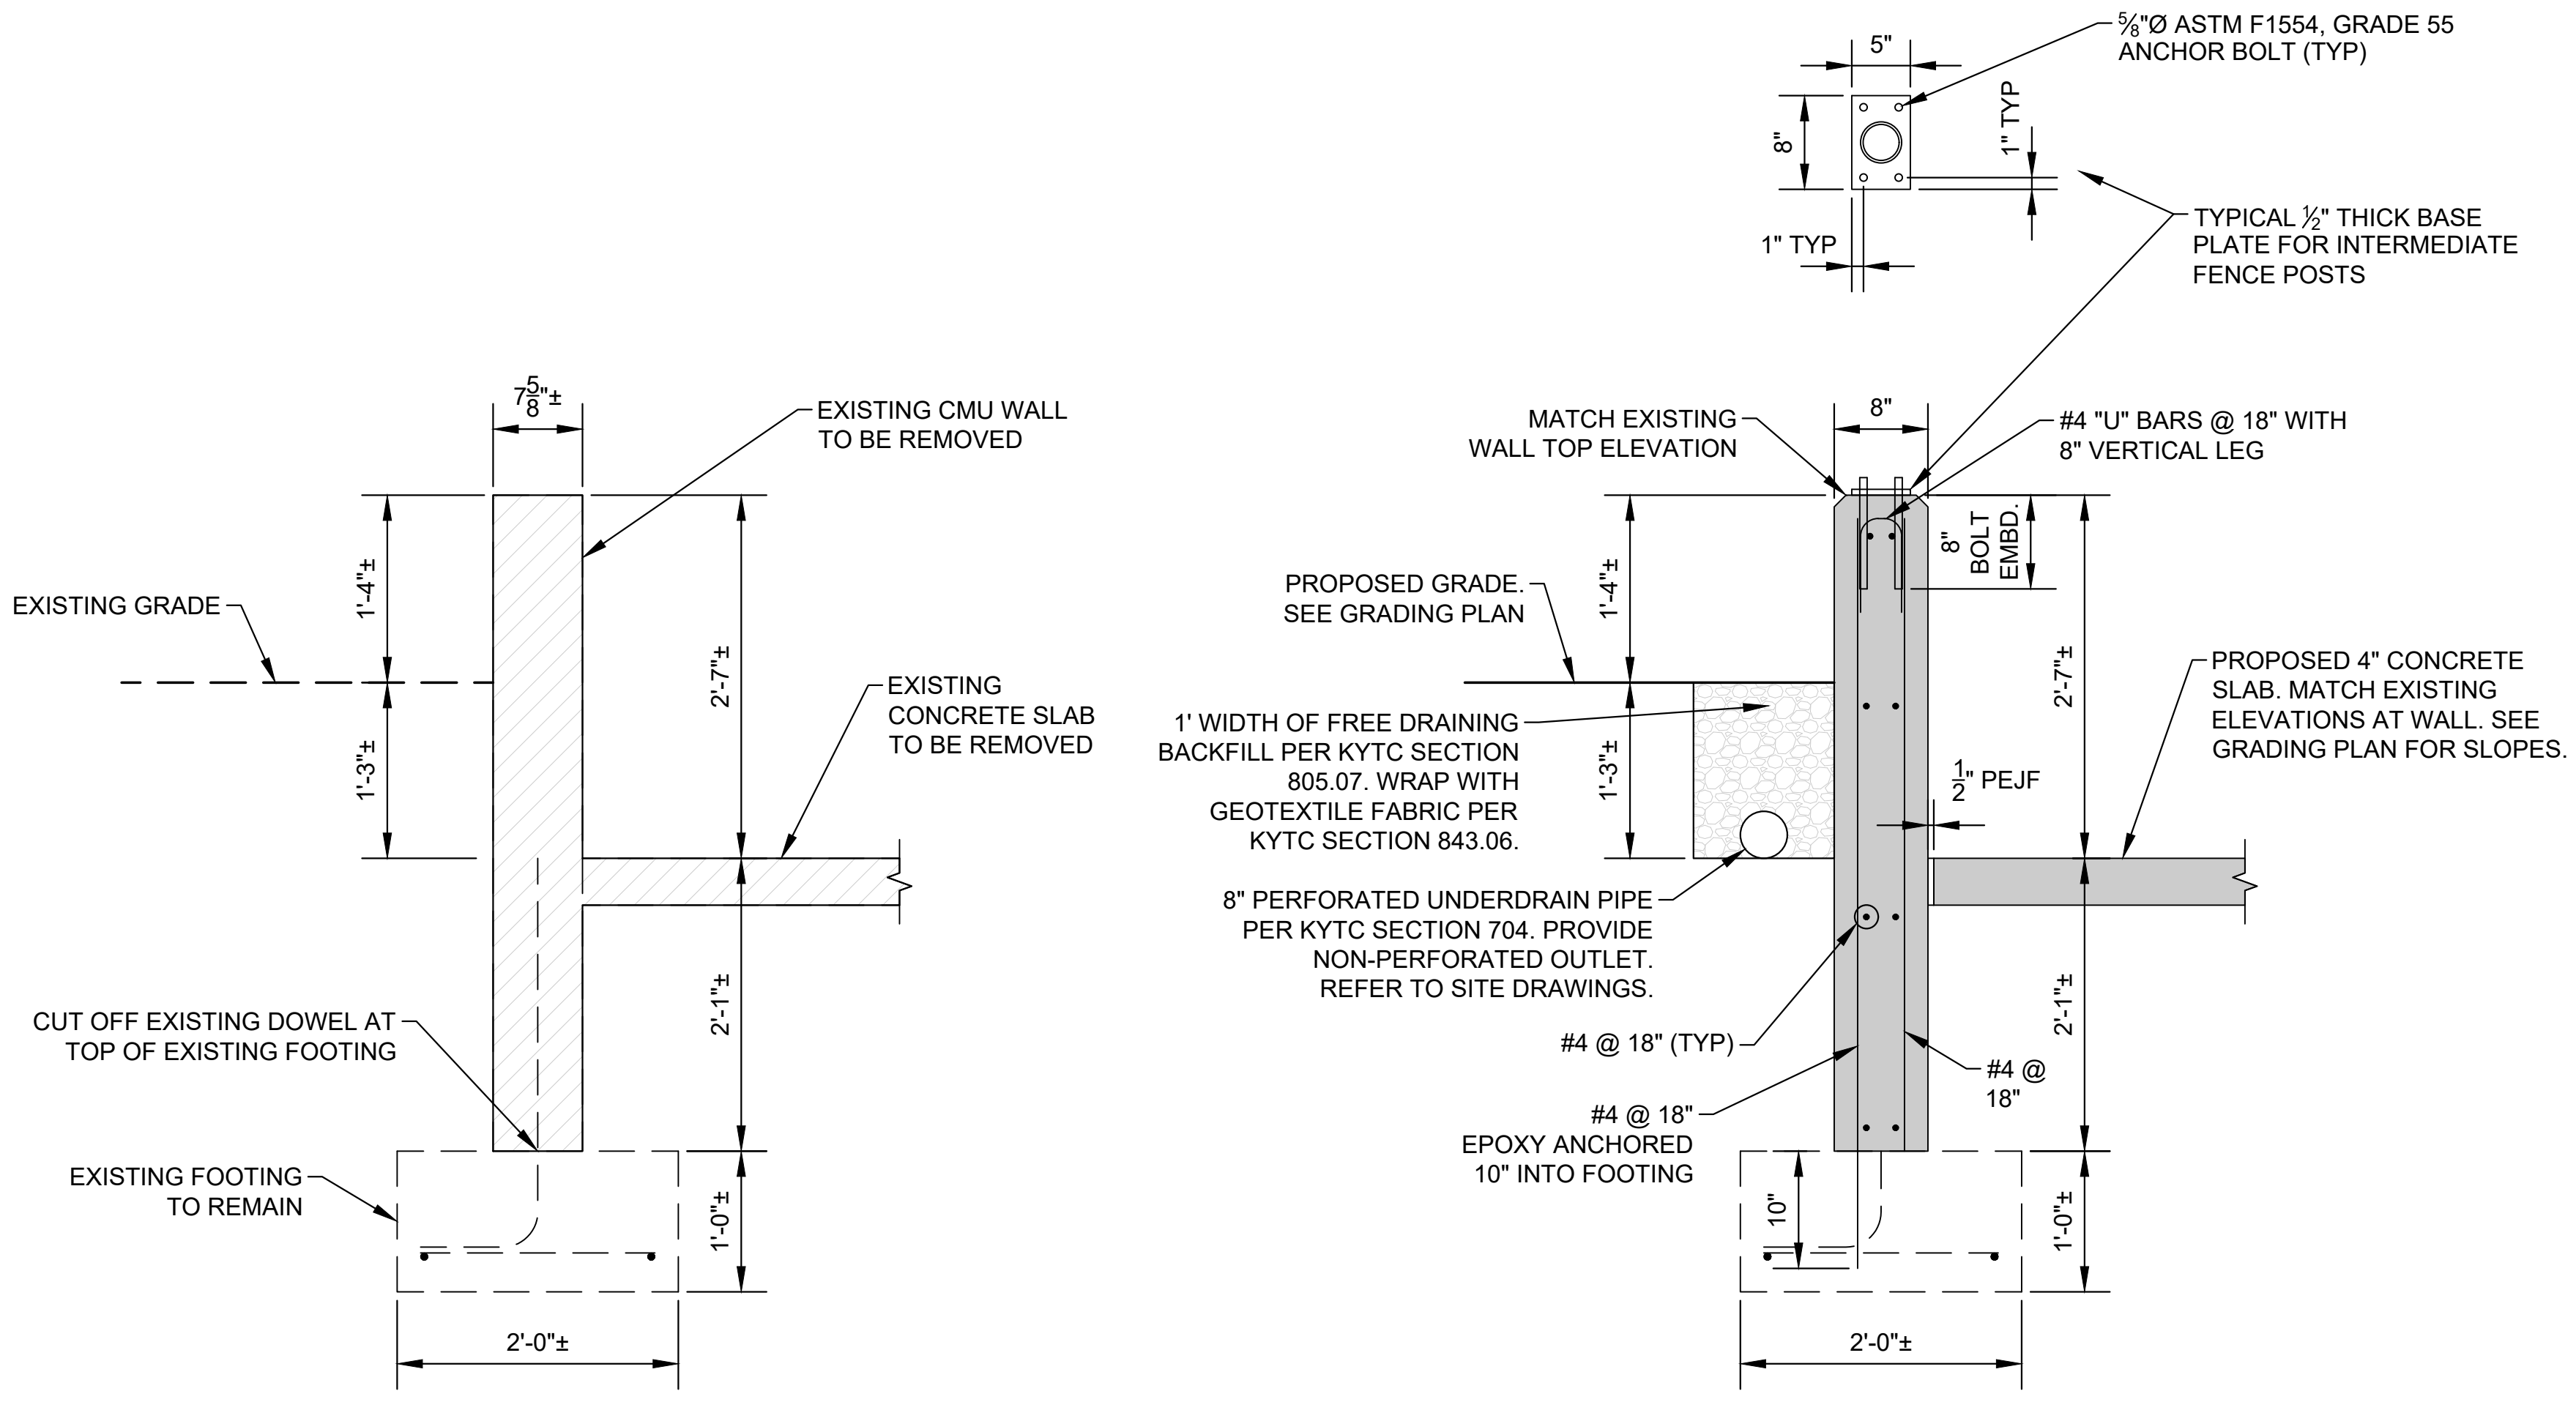

SECTION A-A - TYPICAL WALL

STRUCTURAL NOTES:

- REFERENCES TO KYTC SECTION NUMBERS:
- KYTC SECTION NUMBERS REFER TO THE 2019 EDITION OF THE KYTC STANDARD SPECIFICATIONS FOR ROAD AND BRIDGE CONSTRUCTION. COMPLY WITH ALL REQUIREMENTS OF THE SECTION NUMBER CITED, AS WELL AS ALL OTHER KYTC SECTION NUMBERS CITED THEREIN.
 - THE KYTC STANDARD SPECIFICATIONS ARE AVAILABLE FOR FREE DOWNLOAD FROM THE KYTC WEBPAGE.

- DESIGN LOADS, MATERIAL PROPERTIES AND FOUNDATION CAPACITY:
- NO BORINGS OR GEOTECHNICAL REPORT INFORMATION WERE AVAILABLE FOR THE WALL DESIGN. ALL DESIGN LOADS, FOUNDATION AND RETAINED MATERIAL PROPERTIES, AND FOUNDATION CAPACITIES ARE BASED ON PROFESSIONAL EXPERIENCE AND ASSUMPTIONS.
 - ACTIVE LATERAL EARTH PRESSURE = 60 pcf EQUIVALENT FLUID.
 - NO LATERAL PRESSURE FROM SURCHARGES ON THE SURFACE OF THE FINISHED GRADE ON THE HIGH SIDE OF THE WALL WERE INCLUDED
 - ALLOWABLE FOUNDATION BEARING PRESSURE = 2,000 psf
 - COEFFICIENT OF FRICTION FOR RESISTING SLIDING = 0.25
 - ALLOWABLE PASSIVE PRESSURE = 150 pcf.

- EXCAVATION FOR WALL:
- THE CONTRACTOR IS RESPONSIBLE FOR FOLLOWING ALL OSHA REQUIREMENTS PERTAINING TO SAFE EXCAVATION PRACTICES.
 - THE CONTRACTOR SHALL DESIGN ALL REQUIRED CONSTRUCTION SHORING.

- EXISTING FOUNDATION:
- THE EXISTENCE OF THE 2'-0"± WIDE FOOTING BELOW THE EXISTING CMU WALLS IS BASED ON RECORD DRAWING L7 FROM THE 1998 CONSTRUCTION DRAWINGS.
 - NOTIFY THE ENGINEER IMMEDIATELY IF THIS FOOTING IS SMALLER THAN INDICATED OR IF IT DOES NOT EXIST.

- EXISTING FENCING:
- THE POSTS ON TOP OF THE EXISTING CONCRETE END WALLS AND THE MIDDLE CONCRETE PIER ARE TO REMAIN IN PLACE.
 - DOCUMENT THE LOCATION OF THE TWO INTERMEDIATE FENCE POSTS FOR ANCHOR BOLT PLACEMENT FOR LATER POST RE-INSTALLATION.
 - REMOVE AND STORE THE EXISTING FENCE FABRIC, THE BOTTOM HORIZONTAL FENCE MEMBERS, AND THE TWO INTERMEDIATE FENCE POSTS.
 - MODIFY THE TWO EXISTING INTERMEDIATE POSTS BY TRIMMING AS NECESSARY AND WELDING THE BASE PLATE SHOWN TO THE BOTTOM OF EACH POST.
 - RE-INSTALL THE MODIFIED INTERMEDIATE POSTS TO THE TOP OF THE COMPLETED PROPOSED CONCRETE WALL WITH THE ANCHOR BOLTS THAT WERE CAST INTO THE WALL.
 - RE-ATTACH THE EXISTING BOTTOM HORIZONTAL FENCE MEMBERS AND FENCE FABRIC.

- CONCRETE:
- ALL CONCRETE CONSTRUCTION SHALL CONFORM TO THE BUILDING CODE REQUIREMENTS OF THE AMERICAN CONCRETE INSTITUTE.
 - REINFORCING STEEL SHALL COMPLY WITH KYTC SECTION 602 AND MEET ASTM A 615, GRADE 60.
 - CONCRETE SHALL COMPLY WITH KYTC SECTION 601, CLASS AA, 4,000 psi COMPRESSIVE STRENGTH.
 - THE MINIMUM REINFORCING STEEL LAPS ARE:
#4 = 30"
 - PROVIDE 2" CLEAR COVER OVER ALL REINFORCING IN THE WALL.
 - ALL EXPOSED WALL CORNERS SHALL HAVE 3/4" CHAMPFERS.

- TYPICAL DETAILS:
- DETAILS LABELED "TYPICAL" ON THE DRAWINGS SHALL APPLY TO ALL SITUATIONS OCCURRING ON THE PROJECT THAT ARE THE SAME OR SIMILAR TO THOSE SPECIFICALLY DETAILED. SUCH DETAILS SHALL APPLY WHETHER OR NOT THEY ARE KEYED AT EACH LOCATION.

- CONSTRUCTION:
- CONTRACTOR SHALL BRACE THE ENTIRE STRUCTURE AS REQUIRED TO MAINTAIN STABILITY UNTIL COMPLETE AND FUNCTIONING AS THE DESIGNED UNIT.

- EXISTING CONDITIONS:
- FIELD VERIFY ALL EXISTING CONDITIONS, DIMENSIONS AND ELEVATIONS BEFORE FABRICATING ANY MATERIALS. NOTIFY ENGINEER IMMEDIATELY OF ANY EXISTING CONDITIONS THAT DIFFER FROM THE CONSTRUCTION DOCUMENTS BEFORE PROCEEDING.

- SAFETY:
- IN ACCORDANCE WITH GENERALLY ACCEPTED CONSTRUCTION PRACTICES, THE CONTRACTOR WILL BE SOLELY RESPONSIBLE FOR CONDITIONS OF THE JOB SITE, INCLUDING SAFETY OF ALL PERSONS AND PROPERTY.
 - PERFORMANCE OF THE THIS REQUIREMENT SHALL APPLY CONTINUOUSLY AND SHALL NOT BE LIMITED TO NORMAL WORKING HOURS.
 - IF ENGINEER PROVIDES CONSTRUCTION REVIEW SERVICES, SUCH SERVICES SHALL NOT INCLUDE REVIEW OF THE CONTRACTOR'S SAFETY MEASURES IN, ON, OR NEAR THE CONSTRUCTION SITE.

SCALE:

NO.	DATE	DESCRIPTION
1	04/30/2021	FOR BID

**NKU SOFTBALL
FIELD
RENOVATIONS**
CITY OF HIGHLAND HEIGHTS
CAMPBELL COUNTY
COMMONWEALTH OF KENTUCKY

PROJECT NO: 080115.036
DATE: APRIL 2021

SCALE: **VARIES**

SHEET NAME: **STRUCTURAL
DETAILS**

SHEET NO. **S100**

